


DX 78-1 McPherson

KANSAS

Section 17 Township 19 Range 1W

Well No. 1 Otte

Company Harms & Burt

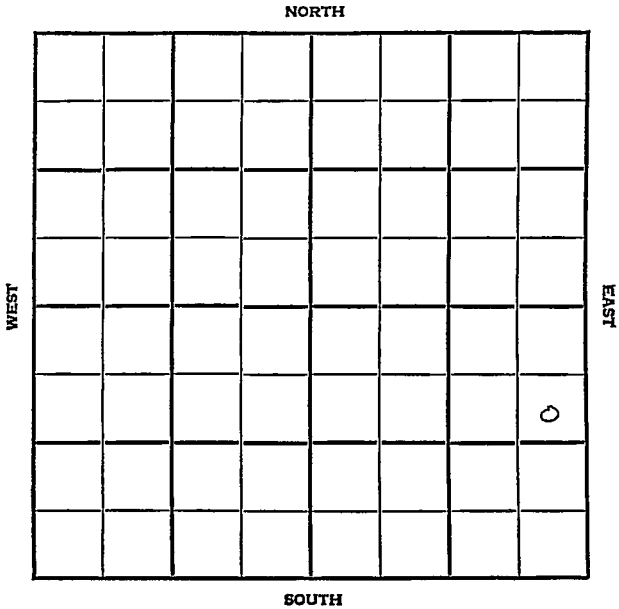

McPherson KANSAS

SEC.	TWP.	R.
17	19	1W

WELL NO. **1 Otte** FARM

COMPANY **Harms & Burt**

CONTRACTOR **Go. Tools**


Ritz-Canton Pool

990 Ft. from N. Line

_____ Ft. from S. Line

330 Ft. from E. Line

_____ Ft. from W. Line

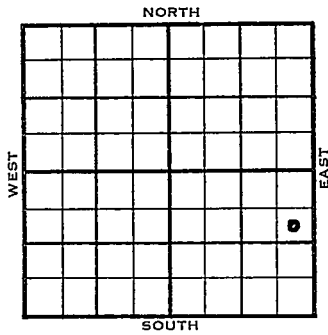

SE NE SE
NCRA FO

1955	ELEVATION	REPORT
------	-----------	--------

4/27 Spud 4-18-55
8" @ 128'
Lans. 2336'
Drlg. 2850'

County McPherson State Kansas

Sec. 17 (Blk. (Twp.) 19) (Sur. Rge.) IW Map No.

Operator Harms & Burt

Well No. 1 Farm Otte

Elev. Location SE NE SE

FIRST REPORT					0

990 Ft. From N Line SE

330 Ft. From E Line Quarter

1st. Report APR 27 1955

Completion

Remarks NGRA farmout

Co. tools

Spudding Date 4-18-55

Drlg. Data Ritz-Canton Pool

8" @ 128 Lens. 2336 drlg. 2850