

Cowley

KANSAS

Section 12 Township 32 Range 5E


Well No. 1 - Miller

Company McNish & Grallop

NORTH

WEST

EAST

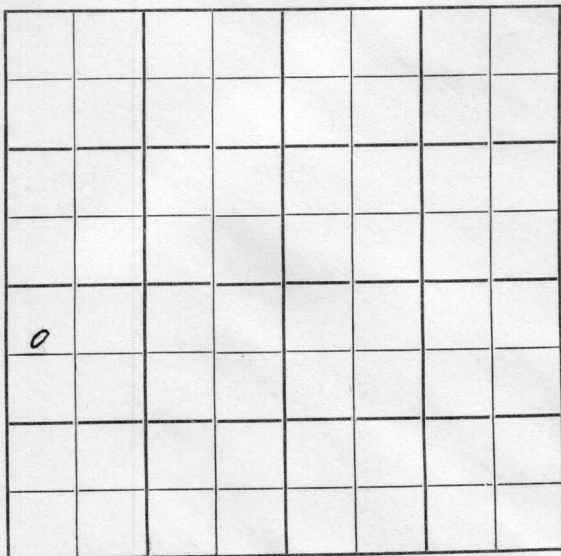

SOUTH

Cowley

KANSAS ✓

Sec. 12 Twp. 32 R. 5EWell No. 1 Miller FarmMcNish & Grallop CompanyWatson Drlg. Contractor


Wildcat

330 Ft. from N. Line

Ft. from S. Line

330 Ft. from E. Line330 Ft. from W. Line

NW NW SW

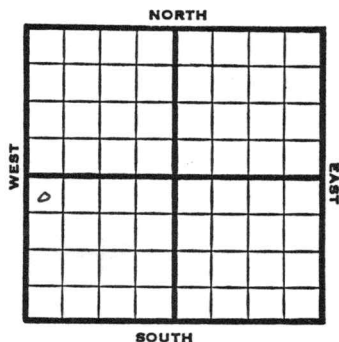

1952

Elev. 1328 REPORT

12/30 RUR

2/11

Spudding Date 12/30/52

Oil Well TD 3092


8" @ 150 Bart. 3014 Miss. 3075

TD 3092 5" @ 3060 CO to 3078 PB

3058 48/3050-58 Hydro. S & F/load
shut in 12 hr. P/75 bo 20 bwph

Comp. 25 bopd

COMPLETED

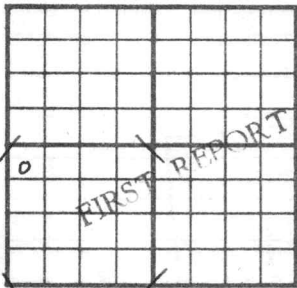County Cowley State KansasSec. 12 (Blk.) 32 (Sur.) 5E Map No.
(Twp.) (Rge.)Operator McNish & GrallopWell No. 1 Farm MillerElev. Location NW NW SW330 Ft. From N Line SW330 Ft. From W Line Quarter1st. Report DEC 30 1952

Completion


Remarks

Watson Drlg. - Contr.

Spudding Date

Drlg. Data WildcatRUR

County Cowley State Kansas
 Sec. 12 (Blk. 32) (Sur. 5E) (Twp.) Map No.
 Operator McNish & Grallop
 Well No. 1 Farm Miller
 Elev. 1328 Location NW NW SW

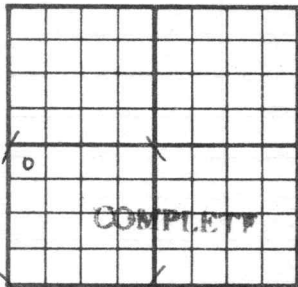

330 Ft. From N Line SW
330 Ft. From W Line Quarter
 1st. Report
 Completion FEB 11 1953
 Remarks Wildcat
Watson Drlg. - Contr.
 Spudding Date 12-30-52

Drlg. Data Oil well TD 3092
8" @ 150 Bart. 3014 Miss. 3075
TD 3092 5" @ 3060 CO to 3078 PB 3058
48/ 3050-58 Hydro. S & F/ load
shut in 12 hr. P/ 75 bo 20 bwpd
Comp. 25 bopd