


Map No. 2- Butler Sec. 8 Twp. 27 R. 6E
 Well No. Butler Farm _____ Company _____

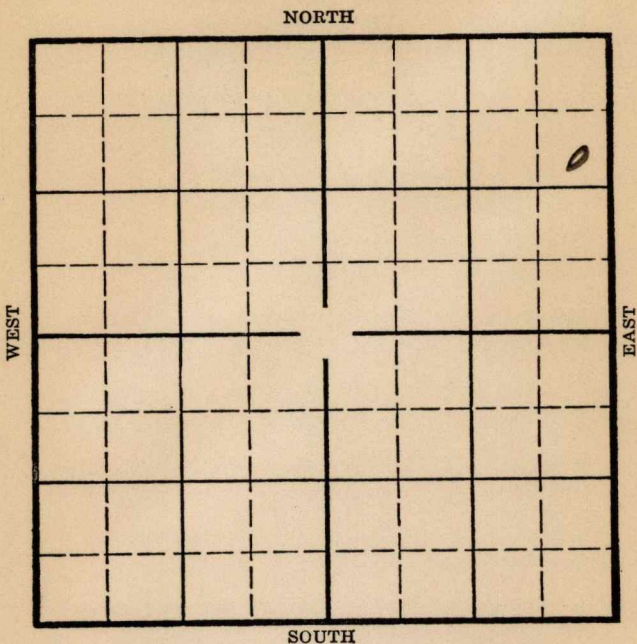

Location _____
 Drilling Remarks _____

Rig Up _____
 Drilling Remarks _____

RECORD

Cased _____ in. _____ ft.
 Sand _____
 Gas _____
 Oil _____
 Total Depth _____

PRODUCTION

1st 24 hrs. Nat. _____
 1st 24 hrs. after shot _____
 Gas _____ cu. ft. _____
 Dry Hole _____
 Abandoned _____

Butler

Map No. **KANSAS** Sec. 8 Twp. 27 R. 6E

Well No. 2- Beadles Farm

Becker Company


1020 Ft. from N. Line

 Ft. from S. Line

300 Ft. from E. Line

 Ft. from W. Line

Elev. 1397

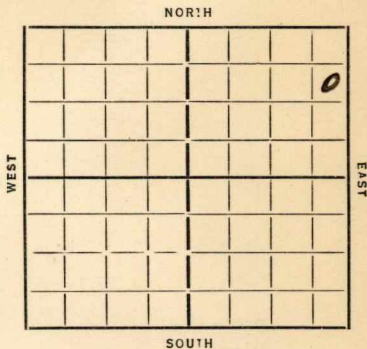

REPORT

Date 1935
9/4 Appl.
10/3 6" 2326 TD 2734 Run 5"
10/19
11/1 5" 2752 TD 2765
 400' Oil test
11/3 TML 1745
 TD 2765
 28 Bbls.

COMPLETED

KANSAS

Map No. 11 Sec. 8 Twp. 27 R. 6EWell No. 2-BeadlesBecker

Company

Contractor

FIRST REPORTS

SECTION PLAT

			0

1020 Ft. from N. Line

Ft. from S. Line

300 Ft. from E. Line

Ft. from W. Line

Location

Rig up

Drilling and Remarks:

Spud

RECORD

Cased _____ in., _____ ft.

Sand _____

Gas _____

Oil _____

Total Depth _____

PRODUCTION

1st 24 hrs. Nat. _____

1st 24 hrs. after shot _____

Gas _____ Cu. Ft.

Dry Hole _____

Abandoned _____

Date

ORVAL MANNSCHRECK

9-4-35 192

Scout

Map No. 11 Sec. 8 Twp. 27 R. 6EWell No. 2-BeadlesG. L. Becker Company

Contractor

COMPLETED

SECTION PLAT

1120 Ft. from N. Line

Ft. from S. Line

300 Ft. from E. Line

Ft. from W. Line

			<u>0</u>

Location

Rig up

Drilling and Remarks:

28 kph

RECORD

Cased _____ in. _____ ft.

Sand TML 1745

Gas _____

Oil _____

Total Depth 2765

PRODUCTION

1st 24 hrs. Nat. _____

1st 24 hrs. after shot _____

Gas _____ Cu. Ft.

Dry Hole _____

Abandoned _____

Date

11-13-35 192 ORVAL MANNSCHRECK Scout