


Map No. _____ Sec. 8 Twp. 27 R. 6
 Well No. 1 - Beadles Farm
Phillips Pet. Company

NORTH

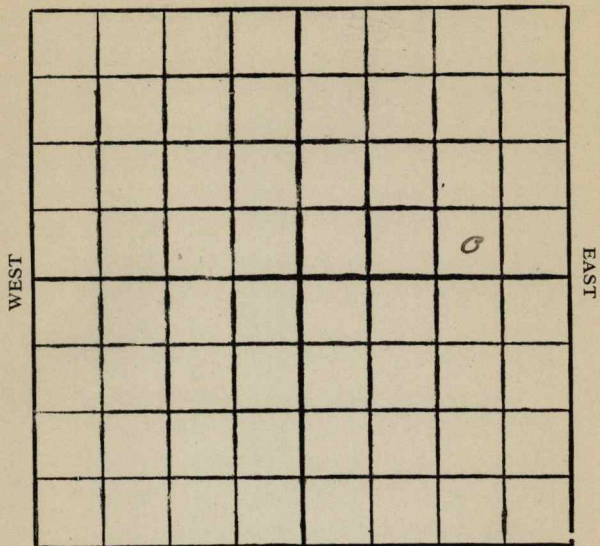

SOUTH

Location _____

Drilling Remarks _____

Rig Up _____

Drilling Remarks _____

RECORD

Cased _____ in. _____ ft.

Sand _____

Gas _____

Oil _____

Total Depth _____

PRODUCTION

1st 24 hrs. Nat. _____

1st 24 hrs. after shot _____

Gas _____ cu. ft.


Dry Hole _____

Abandoned _____

Butler

Map No. 15 Sec. 8 Twp. 27 R. 6Well No. 1-Beardles Farm
Phillips Pet. Company

NORTH

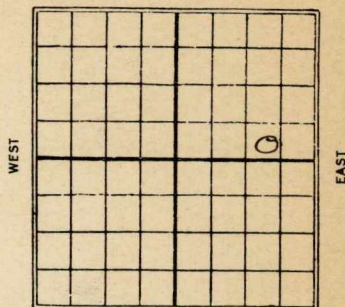

Ft. from N. Line

530 Ft. from S. Line990 Ft. from E. Line

Ft. from W. Line

1927

Date

REPORT

2/3	Bldg Rig
2/10	
2/17	Spudding
2/24	Drlg 800
3/2	fishing 1320
3/9	Drlg 1930
3/16	" 2620
3/24	good show oil 2764-87
	Drilling 2835
3/30	Wilcol 3145-3149
	Topline 2764
	Good show oil 2764-87
	100 bbls

11 **KANSAS**Map No. _____ Sec. 8 Twp. 27 R. 6Well No. BeaslesPhillips pet Co Company

Contractor _____

FIRST REPORTS

_____ Ft. from N. Line

330 Ft. from S. Line990 Ft. from E. Line

_____ Ft. from W. Line

SECTION PLAT

			0

Location Blog Ry

Rig up _____

Drilling and Remarks:

RECORD

Cased _____ in., _____ ft.

Sand _____

Gas _____

Oil _____

Total Depth _____

PRODUCTION

1st 24 hrs. Nat. _____

1st 24 hrs. after shot _____

Gas _____ Cu. Ft.

Dry Hole _____

Abandoned _____

Date

DEC 3 1927 CHAS. L. SHERWOOD

192

Scout

11 **KANSAS** Sec. 8 Twp. 27 R. 6

Well No. 1 *Beards*

Phillips Pet Co Company

Contractor

COMPLETED

SECTION PLAT

----- Ft. from N. Line

330 Ft. from S. Line

990 Ft. from E. Line

----- Ft. from W. Line

			0

Location ----- *Wilcox*

Rig up -----

Drilling and Remarks:

Top line 2764'
Sand show 2764-87'

RECORD

Cased ----- in., ----- ft.

Sand *3145-3149*

Gas -----

Oil -----

Total Depth *3149'*

PRODUCTION

1st 24 hrs. Nat. -----

1st 24 hrs. after shot -----

Gas ----- Cu. Ft.

Dry Hole -----

Abandoned -----

Date

MAR 30 1927 CHAS. L. SHERWOOD

192

Scout