


Section 17 Township 19 Range 1W

Well No. #2 German

Company Alfred Koehn (Galve)

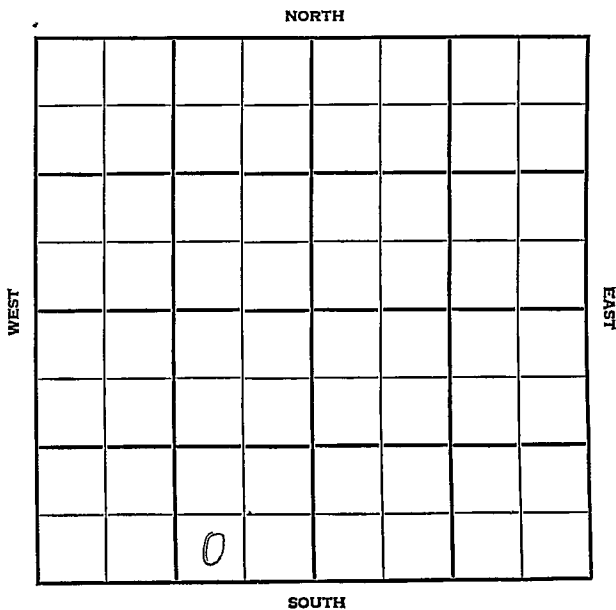

County McPherson Elev. _____
 Sec. 17 Twp. 19 Rge. 1W
 Company Alfred Koehn (G alva)
 Farm Name German No. 2

TOPS	DEPTH	LOG	DATUM
Anh.			
Tp.			
H.			
Tr.			
Dg.			
Bl.			
L.			
K.C.			
B.K.C.			
Ce.			
C.			
M.	2926		
M.			
K.			
Mz.			
Mo.			
V.			
S.			
S.			
A.			
R.			
Pe.			
G.			
T.D.	2991		

Loc. in Sec. SW SEW

Geol. _____

Contr. Melland

Pool Ritz-Canton

FIRST REPORT
 JAN 9 '57
 O K

Date Comm. 1-2-57
8" @ 160 5" @ 2979

~~///~~

Co.
Lse.
No.
Sec.
T.
R.

Co.
No.
Sec.
T.
R.

County McPherson Elev. _____
 Sec. 17 Twp. 19 Rge. 1W
 Company Alfred Koehn (G alve)
 FarmName German No. 2

TOPS	DEPTH	LOG	DATUM	Loc. in Sec.
Anh.				SW S ⁴ S ¹ J
Tr.				
H.				
Tr.				
Dg.				
Bl.				
L.				Geol. _____
K.C.				Contr. _____
B.K.C.				
Ce.				Melland
C.				Pool
M.	2926			Ritz-Canton
M.				
K.				
Mz.				
Mo.				
V.				
S.				
S.				COMPLETE
A.				
R.				
PE.				JAN 16 '57
G.				
TD.	2991			OX

Date Comm. 1-2-57
8" @ 160 5" @ 2979 JAN 16 '57 DD 2998
1/2" @ 6 1/2 Bopd 50% wtr.
Pop. P. 25 Bopd 50% wtr.