
McPherson

KANSAS

SECTION 17 TOWNSHIP 19S RANGE 1W

WELL NO. #2 Otte

COMPANY Harms & Burt

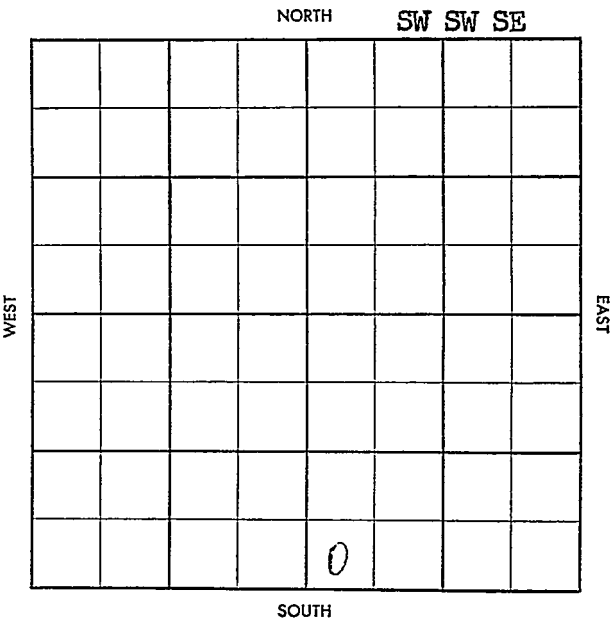

Twp. X Pool X

Co. X Facet

S-513-B

County McPherson Elev. 1574

Sec. 17 Twp. (19) Rge. 1W

Company Harms & Burt

Farm Name Otte No. 2

TOPS	DEPTH	LOG	DATUM
Anh.			
Tp.			
H.			
Tr.			
Dg.			
B. L.			
L.			
K.C.			
B.K.C.			
Ce.			
C.			
M.	2918		
M.			
K.			
Mz.			
Mq.			
V.			
S.			
S.			
A.			
R.			
Pf.			
G.			
T.D.	2942		

Loc. in Sec. SW SW SE

Geol.

Contr. Co. tools


Pool Ritz-Canton

JUN 17 '58 FIRST REPORT

Date Comm. 6-2-58

8" @ 210

Co. Lse. No. Sec. T. R.

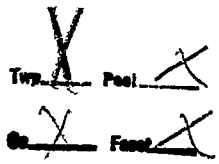

S-513-B

County McPherson Elev 1574 DF

Sec. 17 Twp. 19 Rge. 1W 137748

Company Harms & Burt

Farm Name Otte No. 2

TOPS	DEPTH	LOG	DATUM
Anh.			
Tp.			
H.			
Tr			
Dg.			
B.L.			
L.			
K.C.			
B.K.C.			
Ce.			
C.			
M.	2918		
M.			
K.			
Mz.			
Mq.			
V.			
S.			
S.			
A.			
R.			
Pf.			
G.			
T.D.	2912		

Loc. in Sec. SW SW SE

Geol.

Contr Co. tools

Pool Ritz-Canton

COMPLETE

JUL 2 '58

Date Comm. 6-2-58

8" @ 210 JUN 18 '58 5" 2941 co

JUN 25 '58 JUL 2 '58 DD 2984 TD (1/2)

$ 4½ BO 9 Bwph 5 hrs pop

P 25 BO + 50 Bw pd

miss

Co. Lse. No. Sec. T. R.