


SECTION 17 TOWNSHIP 19 RANGE 1W

WELL NO. #3 German

COMPANY A1 Koehn

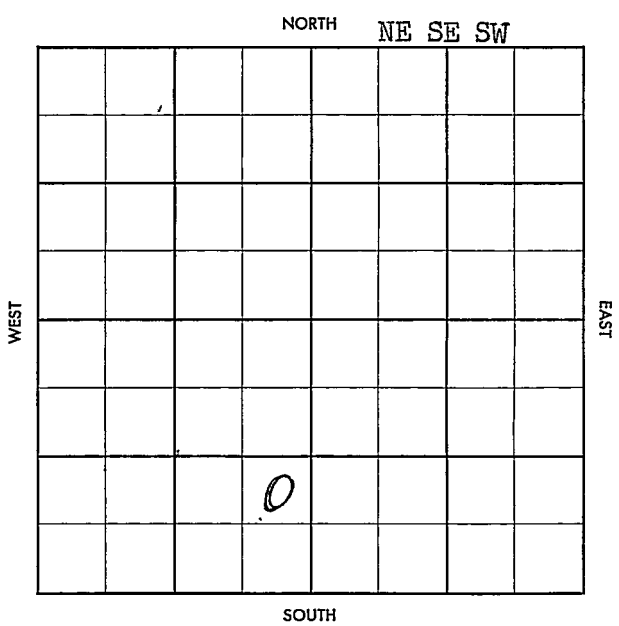

County McPherson Elev. 1574
 Sec. 17 Twp. 18 Rgs. 1W
 Company Al Koehn
 Farm Name German No. 89

Co.

TOPS	DEPTH	LOG	DATUM	Loc. in Sec.
Anh.				NE SE SW
Ip.				SW
H.				
Tr.				
Dg.				
BL.				
L.				
K.C.				Geol.
B.K.C.				Contr.
Ce.				
C.				Welland Tool
M.	2933			Pool
M.				
K.				
Mz.				Witz-Cartoh
Ma.				
V.				
S.				
S.				
A.				
R.				
PE.				
G.				
T.D.	2965			

1563

COMPLETE
 AUG 7 '57

No.

Date Comm. W O R T JUN 19 '57 ✓ 6-13-57
878 156 5 1/2 2960 Ø 10
JUL 10 '57 ✓ JUL 24 '57 JUL 31 '57
DD 2990 13/4 \$ 4 Bopd
60% wt. P. est 25 Bopd
60% wt.

Sec.

T.

R

~~XXXXXXXXXX~~

