

Cowley

Section 12 Township 32 Range 5E

Well No. #1 J. C. Miller

Company Sunray Oil Company

NORTH

WEST

EAST

0							

SOUTH

Cowley

KANSAS

Sec. 12 Twp. 32 R. 5E

Well No. #1 J. C. Miller Farm

Sunray Oil Company Company


Contractor

Ft. from N. Line

330 Ft. from S. Line

Ft. from E. Line

330 Ft. from W. Line

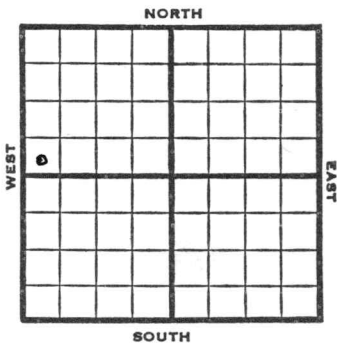

SW SW NW

1953 Elev. 1336' REPORT

3/18 Location

4/22 Spud 3-22-53

D & A

TD 3060'

8" @ 147'

Layton 2356, KC 2498, B KC 2812, Prue 2844, Bart 3022

TD 3056

5" @ 3050

CO to 3056

50 M-A DD 3060 2 go 2 hr. sd-frac

PB 3055 40 bw 5 bo 5 hr. PB 3052

S/ 1 bo 8 bwph

D & A

**ABANDONED**



