

Section 13 Township 32 Range 5 E


Well No. #1 Atkinson

Company Baehus Oil, Bedell & Catt & Morrison  
Drlg.

NORTH

WEST

EAST

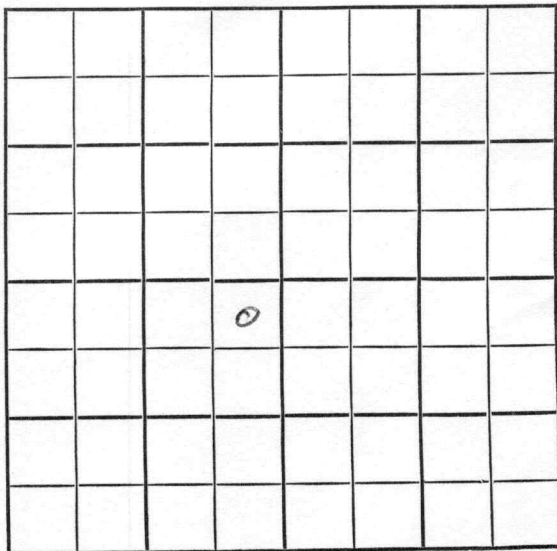

SOUTH

Cowley

KANSAS

SEC. 13	TWP. 32	R. 5E
------------	------------	----------

WELL NO.

#1 Atkinson

FARM

COMPANY

Bachus Oil, Bedell &amp; Catt &amp; Morrison Drlg.

CONTRACTOR

Morrison

Silver Creek


Ft. from N. Line

Ft. from S. Line

Ft. from E. Line

Ft. from W. Line

NE NE SW

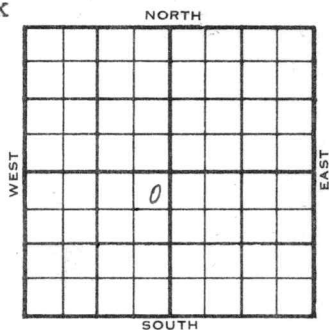

K. T. Weidemann - DHM

Gene Scofield - FO

1956	ELEVATION	REPORT
	1281	
2-29	Comm. 2-27-56	
3/28	Comm 2-27-56	
	Lay	2260-80
	KC	2436
	BKC	2542
	Ft Sct	2694-2750
	Btul	2934
	Chart	3028
	li	3036
	TD	3102
	8 5/8" @ 157/120 DST 2260-67 open	
	1 hr rec 250' sw 750# DST 3036-53	
	open 1 hr rec 15' mud 98#	
	DST 3006-14 open 1 hr rec 240' gas	
	120' ocm & mw 870# 5 1/2" @ 3102	
	CO 16/3082-86 8/3006-08	
	PB 2990 8/2964-76 frac S/2 1/2 bo 8 bwph	
	16 hr Comp 25 bopd 75% wtr	

COMPLETED

County Cowley Elev. \_\_\_\_\_  
 Sec. 13 Twp. 32 Rge. 5E  
 Company Bachus Oil, Redell & Catt & Morrison  
 Farm Name Atkinson No. 1 Drig.

TOPS	DEPTH	LOG	DATUM
Anh.			
Tp.			
H.			
Tr.			
Dg.			
Bl.			
L.			
K.C.			
B.K.C.			
Ce.			
C.			
M.			
M.			
K.			
Mz.			
Me.			
V.			
S.			
S.			
A.			
R.			
Pe.			
G.			
T.D.			

Loc. in Sec. NE NE SW  
 Geol. \_\_\_\_\_  
 Contr. Morrison  
 Pool Silver Creek

FIRST REPORT  
 FEB 29 1956

Date Comm. 2-27-56 K.T. Weidemann - DHM  
 Gene Scofield - FO

Co.  
 Lse.  
 No.  
 Sec.  
 T.  
 R.

County Cowley Elev. 1281  
 Sec. 13 Twp. 32 Rge. 5E  
 Company Bachus Oil, Bedell & Catt &  
 Farm Name Atkinson Morrison Drlg. No. 1

TOPS	DEPTH	LOG	DATUM
Anh.			
TP.			
H. <u>Lay</u>	<u>2260-80</u>		<u>979</u>
Tr.			
Dg.			
BL.			
L.			
K.C.	<u>2436</u>		<u>1155</u>
B.K.C.	<u>2542</u>		<u>1261</u>
Ce. <u>Et Set</u>	<u>2694-2750</u>		<u>1413</u>
C. <u>BTKI</u>	<u>2934</u>		<u>1653</u>
M. <u>chert</u>	<u>3028</u>		<u>1747</u>
M. <u>LI</u>	<u>3036</u>		<u>1755</u>
K.			
Mz.			
Mq.			
V.			
S.			
S.			
A.			
R.			
PE.			
G.			
T.D.	<u>3102</u>		

Loc. in Sec. NE NE SW  
 Geol. Morrison  
 Contr. Morrison  
 Pool Silver Creek



Date Comm. 2-27-56  
8 5/8" @ 157/120 DST 2 260-67 open 1 hr  
rec. 250' sw 750# DST 3036-53  
open 1 hr. rec. 15' mud 98#  
DST 3006-14 open 1 hr. rec. 240' gas  
120' ocm & mw 870# 5 1/2" @ 3102  
CO 16/ 3082-86 8/ 3006-08 PB 2990  
8/ 2964-76 frac S/ 2 1/2 bo 8 bwph  
16 hr. Comp. 25 bopd 75% wtr.

Co.  
 Lse.  
 No.  
 Sec.  
 T.  
 R.