


7-1-258
Plotted acw

HUGH MATTHEWS
Cloverleaf Dairy No. 1.

SEC.7 T.11 R. 25 E
SW NE NE

Total Depth. 280'
Comm. 10-15-41 Comp. 10-30-41
Shot or Treated.
Contractor. W.L.Hendee
Issued. 12-27-41

County. Wyandotte

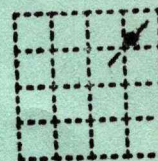

CASING:

Elevation *approx 900 ±*
Topo sheet

Production. Dry

Figures Indicate Bottom of Formations.

clay yellow	40
clay blue sdy	62
lime	70
shale	71
lime	79
shale	103
lime	105
shale	115
lime	126
shale	127
lime	129
shale	130
lime	131
shale	141
lime wh	151
shale dk	158
lime	160
shale	161
lime	164
shale break	164 $\frac{1}{2}$
lime	180
shale	189
lime	191
shale dk	193
lime	194
shale	196
lime	221
shale dk	229
lime	250
shale	253
lime	254
shale	257
lime	265
shale	280
Total Depth.	

7-115-25E

27-F-30

MISSOURI GEOLOGICAL SURVEY AND WATER RESOURCES - ROLLA, MO.

COUNTY Wyandotte LOG NUMBER _____

COMPANY OR OWNER Hugh Matthews

FARM Clover Leaf Dairy WELL NO. 1

LOCATION _____ SEC. 7 T. 11 R. 25

CONTRACTOR W. L. Hender

DRILLER _____ TOOL DR. _____

COMMENCED Oct 1941 COMPLETED _____

PRODUCTION _____ PLOTTED _____


CASING RECORD _____

WATER RECORD _____

SOURCE OF LOG Drillers Original ELEV. _____

REMARKS _____ TOTAL DEPTH 280

CHEM. ANAL. NO. _____

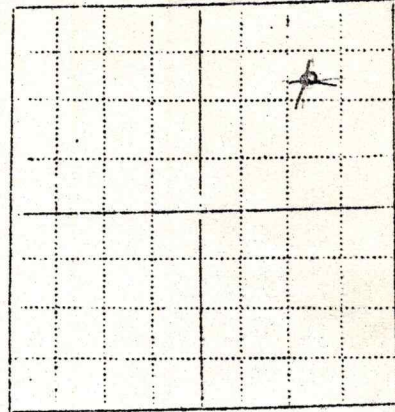

FORMATION	THICK	DEPTH	FORMATION	THICK	DEPTH
Clay yellow	40	0	Lm	15 1/2	164 1/2
Clay blue sandy	32	40	Shale	9	180
Lm	8	62	Lm	2	189
Shale	1	70	Shale dark	2	191
Lm	1	71	Lm	1	193
Shale	2 1/2	79	Shale	2	194
Lm	2	103	Lm	25	196
Shale	10	105	Shale dark	8	196
Lm	9	115	Lm	21	221
Shale	1	126	Shale	3	229
Lm	2	127	Lm	1	250
Shale	1	129	Shale	4	253
Lm	1	130	Lm	8	254
Shale	10	131	Shale	8	257
Lm white cc	10	141	Shale	265	265
Shale dark	7	151			280
Lm	2	158			
Shale	1	160			
Lm	2	162			
Shale break	1/2	164			

10/30/41

Drilled to 502 ±