


7-11-25E

27-F-30

MISSOURI GEOLOGICAL SURVEY AND WATER RESOURCES - ROLLA, MO.

COUNTY Wyanadott LOG NUMBER 141  
 COMPANY OR OWNER W. Vogel  
 FARM W. Vogel WELL NO. \_\_\_\_\_  
 LOCATION Catto SEC. 7 T. 11 R. 25  
 CONTRACTOR Cullison & Brown  
 DRILLER Hugh Lunsford TOOL DR. Fred Lunsford  
 COMMENCED May 1945 COMPLETED 5/15/45  
 PRODUCTION D & A PLOTTED \_\_\_\_\_  
 CASING RECORD \_\_\_\_\_  
 WATER RECORD \_\_\_\_\_  
 SOURCE OF LOG Recessed origin  
 REMARKS \_\_\_\_\_

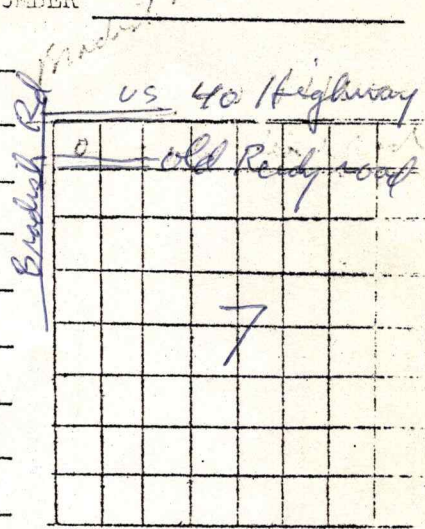

ELEV. \_\_\_\_\_  
 TOTAL DEPTH 435  
 CHEM. ANAL. NO. \_\_\_\_\_

FORMATION	THICK.	DEPTH	FORMATION	THICK.	DEPTH
Boulders & clay	0	9	Shal dark	4	152 : 156
limi lsh	11	9	limi BE	20	156 : 176
Shal blue (water)	5	20	Shal	4	176 : 180
Shal light	20	25	limi NC	2	180 : 182
limi gray R7	11	45	Shal dark	3	182 : 185
Shal gray	4	58	limi 1d	8	185 : 193
Shal green	7	60	Shal white		193 : 207
limi gray CC	10	67	Sand broken gas bubbles		207 : 214
Shal dark	8	77	Shal gray		214 : 230
limi 1d	19	82	Shal gray sandy		230 : 270
Shal dark	9	101	some water		
limi	2	110	Shal gray		270 : 310
Shal dark lsh	2	112	Shal sand		310 : 318
limi	2	114	Shal white		315 : 330
Shal green	4	116	Sand broken		330 : 340
limi	12	120	Shal light		340 : 350
Shal green lsh	3	132	Shal light blue		350 : 364
limi gray	17	135	limi gray		364 : 370

7-11-25E

Shal dark	370	372
L	372	375
Shal grey	375	390
Shal white	390	396
L	396	400
Broken red	400	404
Sand	404	414
Shal grey	414	426
L	426	433
Slat	433	435

W. Vogel farm  
 Sec 7-11-25E