


Section 13 Township 32 Range 5 E

Well No. #1 Miller

Company Beaumont Pet.

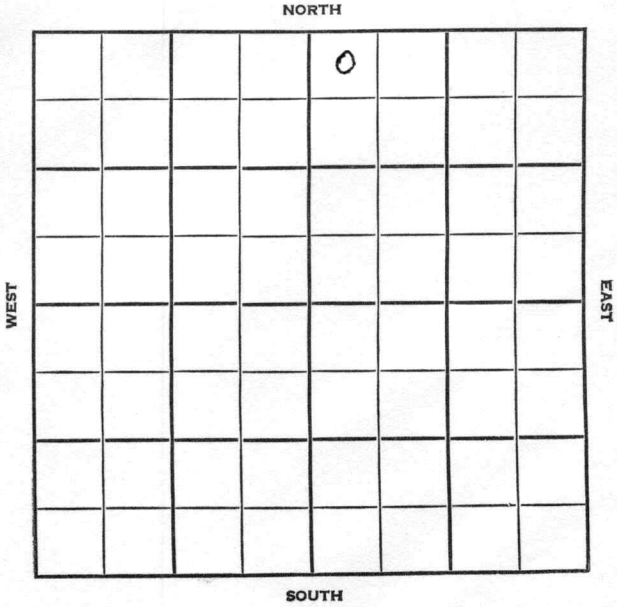

Cowley

KANSAS

SEC. 13	TWP. 32	R. 5E
------------	------------	----------

WELL NO. #1 Miller FARM

COMPANY
Beaumont Pet

CONTRACTOR
Co. Tools
Silver Creek


_____ Ft. from N. Line

_____ Ft. from S. Line

_____ Ft. from E. Line

_____ Ft. from W. Line

NW NW NE

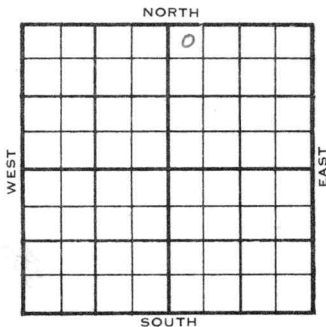

	ELEVATION	REPORT
1955	L" (1298'	

10/5
Comm 9-30-55
8" @ 89/75
Drlg 1200

11/9
Comm 9-30-55
8" @ 89/75
5 1/2" @ 3500
Layton 2266-89
Lime 2443
BKC 2557
Marm 2658
Ce 2775
Bart 2965
Miss 3040
A 3496
TD 3588
CO 27/2965-71 frac
Comp 25 bopd 25 bw

COMPLETED

County Coxley Elev. _____
 Sec. 13 Twp. 32 Rge. 5E
 Company Beaumont Pet.
 Farm Name Miller No. 1

TOPS	DEPTH	LOG	DATUM	Loc. in Sec.
Anh.				NW NW NE
Tp.				
H.				
Tr.				
Dg.				
B.L.				
L.				Geol. _____
K.C.				Contr. _____
B.K.C.				
Ce.				
C.				Co. tools
M.				Pool
M.				
K.				
Mz.				Silver Creek
Ma.				
V.				
S.				
S.				
A.				
R.				
Pe.				
G.				
T.D.				



Date Comm. 9-30-55
8" @ 89/75 drlg. 1200

Co.
Lse.
No.
Sec.
T.
R.

County Cowley Elev. 1298
 Sec. 13 Twp. 32 Rge. 5E
 Company Beaumont Pet.
 Farm Name Miller No. 1

TOPS	DEPTH	LOG	DATUM
Anh.			
Tr.			
Dg.			
Bl.			
L.			
K.C. <u>lime</u>	<u>2443</u>		<u>1145</u>
B.K.C.	<u>2557</u>		<u>1259</u>
Ce. <u>marm</u>	<u>2658</u>		<u>1360</u>
C. <u>Ce</u>	<u>2775</u>		<u>1477</u>
M. <u>Bast</u>	<u>2965</u>		<u>1667</u>
M. <u>Miss</u>	<u>3040</u>		<u>1742</u>
K.			
Mz.			
Mq.			
V.			
S.			
S.			
A.	<u>3496</u>		<u>2198</u>
R.			
PE.			
G.			
T.D.	<u>3588</u>		

Loc. in Sec. NW NW NE

Geol. _____

Contr. _____

Co. tools _____

Pool _____

Silver Creek

COMPLETE

Date Comm. 9-30-55 NOV 9 1955

8" @ 89/75 5 1/2" @ 3500 CO

2 7/2965-71 frac Comp. 25 bopd 25 bw

Co.
Lse.
No.
Sec.
T.
R.