

Butler

Section 8 Township 27 Range 6-E

Well No. #1 McLean (Twin Well)


Company Richman et al

Leon Pool

NORTH

WEST

EAST

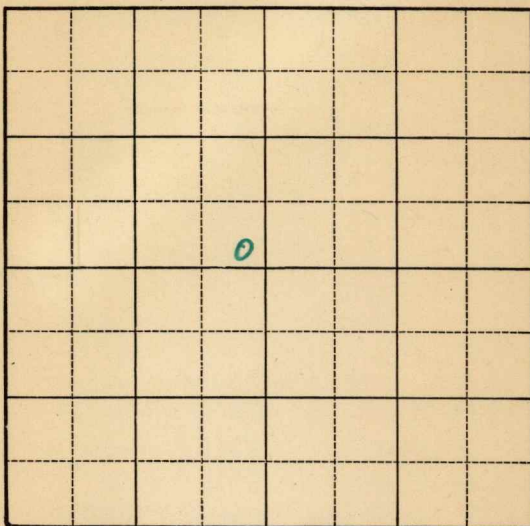

SOUTH

1940
11/27 P.B. 3057' SD.
12/5 TD 3080' Pump 4 bbls. wtr per
hour.
12/12 " "
12/19 " "
12/26 " "
1941
1/2 " "

1/8 Viola 3047'
5" - 3027'
T.D. 3206'
Water.

ABANDONED

Map No. 14 Sec. 8 Twp. 27 R. 6EWell No. 1 McLean (Twin Well)Richman etal Company

Contractor

FIRST REPORT

SE NW

 Ft. from N. Line150 Ft. from S. Line200 Ft. from E. Line Ft. from W. Line

LEON POOL

SECTION PLAT

Location Rig up

Drilling and Remarks:

12" - 735

10" - 1729

Drlg. 1920

RECORDCased in., ft.Sand Gas Oil Total Depth **PRODUCTION**1st 24 hrs. Nat. 1st 24 hrs. after shot Gas Cu. Ft.Dry Hole Abandoned

Date

AUG 21 1940

19

S. J. LEWIS Scout

Map No. 11 Sec. 8 Twp. 27 R. 6EWell No. 1 McLean (Twin Well)Richman etal


Company

Contractor

ABANDONED

SE NW

SECTION PLAT

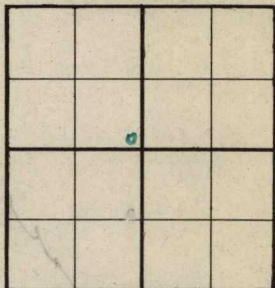 Ft. from N. Line150 Ft. from S. Line200 Ft. from E. Line Ft. from W. Line

LEON POOL

Location Rig up

Drilling and Remarks:

*Vila 3047**5" @ 9027**Water.*

RECORD

Cased in., ft.Sand Gas Oil Total Depth 3206

PRODUCTION

1st 24 hrs. Nat. 1st 24 hrs. after shot Gas Cu. Ft.Dry Hole Abandoned

Date

JAN 8 1941 19S. J. LEWIS Scout