

KANSAS

Cowley


FORM 51 5M 1-42 PETROL

Section 14 Township 32 Range 5-E

Well No. #1 Allen

Company B. B. Blair

NORTH Frog Hollow Pool

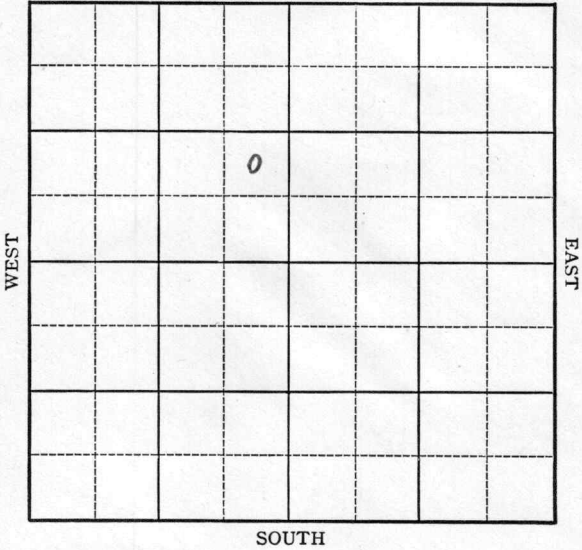

Sec 14 Twp. 32 R. 5-E

Well No. #1 Allen Farm

B. B. Blair Company

(Frog Hollow)


\_\_\_\_\_ Ft. from N. Line

990 Ft. from S. Line

330 Ft. from E. Line

\_\_\_\_\_ Ft. from W. Line

Elev. 1344

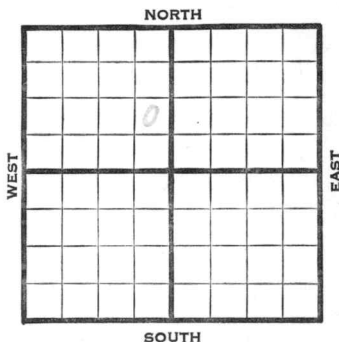

1942	REPORT
4/8	8" - 110' Drlg. 1300'
4/15	Bart. 3033' 5" - 3026' RUST.
4/22	" " "
4/29	Swab 3 oil per hour, SSW.
5/6	T.D. 3063' Shot 30 qts. 3033-45'
	Swab 120 oil in 24 hours.
5/13	Bart. 3033'
	5" - 3026'
	T.D. 3063'
	3033-45
	Potential 381 bbls., pump & flow.
	40.6 Gravity
	COMPLETED

Cowley

KANSAS

Map No. 2 Sec. 14 Twp. 32 R. 5E

Well No. 1 Allen

B. B. Blair Company

**FIRST REPORT**

Contractor

NE SE NW


**SECTION PLAT**

\_\_\_\_\_ Ft. from N. Line

990 Ft. from S. Line

330 Ft. from E. Line

\_\_\_\_\_ Ft. from W. Line

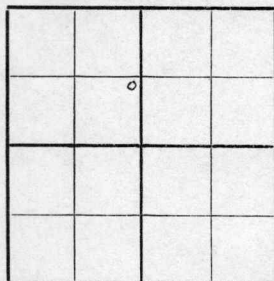

**FROG HOLLOW POOL**

Location \_\_\_\_\_

Rig up \_\_\_\_\_

Drilling and Remarks:

8" - 110'

Drlg. 1300'

**RECORD**

Cased \_\_\_\_\_ in., \_\_\_\_\_ ft.

Sand \_\_\_\_\_

Gas \_\_\_\_\_

Oil \_\_\_\_\_

Total Depth \_\_\_\_\_

**PRODUCTION**

1st 24 hrs. Nat. \_\_\_\_\_

1st 24 hrs. after shot \_\_\_\_\_

Gas \_\_\_\_\_ Cu. Ft.

Dry Hole \_\_\_\_\_

Abandoned \_\_\_\_\_

Date

APR 8 1942 19

S. J. LEWIS Scout

KANSAS

Cowley

Map No. 2 Sec. 14 Twp. 32 R. 5E

Well No. 1 Allen

B. B. Blair Company

**COMPLETED** Contractor

NE SE NW

SECTION PLAT

\_\_\_\_\_ Ft. from N. Line

990 Ft. from S. Line

330 Ft. from E. Line

\_\_\_\_\_ Ft. from W. Line

		o	

FROG HOLLOW POOL

Location \_\_\_\_\_

Rig up \_\_\_\_\_

Drilling and Remarks:

*Bar Y 3033*

*5" 3026*

*3033-45*

*04/1 381 BY*

*40 6 5/8*

RECORD

Cased \_\_\_\_\_ in., \_\_\_\_\_ ft.

Sand \_\_\_\_\_

Gas \_\_\_\_\_

Oil \_\_\_\_\_

Total Depth 3063

PRODUCTION

1st 24 hrs. Nat. \_\_\_\_\_

1st 24 hrs. after shot \_\_\_\_\_

Gas \_\_\_\_\_ Cu. Ft.

Dry Hole \_\_\_\_\_

Abandoned \_\_\_\_\_

Date

MAY 13 1942 19

S. J. LEWIS Scout