


Map No. Sec. 34 Twp. 33 R. 2E

Well No. 1 J. J. Holbridge Farm

Platteau Oil Company

NORTH

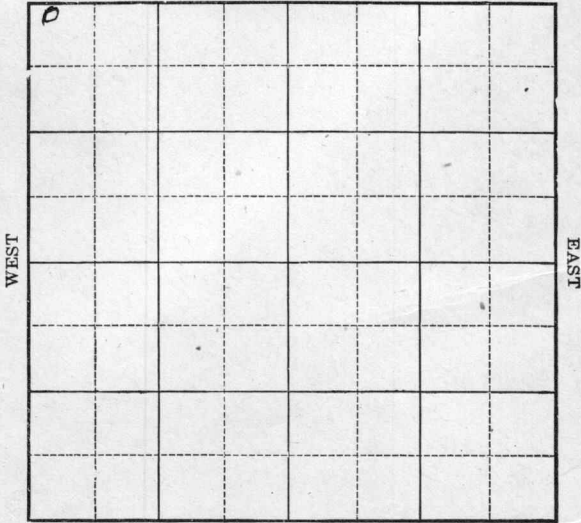

Location _____

Drilling Remarks:

Rig Up _____

Drilling Remarks:

RECORD

Cased _____ in. _____ ft.

Sand _____

Gas _____

Oil _____

Total Depth _____

PRODUCTION

1st 24 hrs. Nat. _____

1st 24 hrs. after shot _____

Gas _____ cu. ft.

Dry Hole _____

Abandoned _____

Kansas

Map No. A-1 Sec. 34 Twp. 33 R. 2E

Well No. 1-J.J. Holdridge

Plateau Oil Company

Contractor

1st Report

SECTION PLAT

0			

----- Ft. from N. Line

----- Ft. from S. Line

----- Ft. from E. Line

----- Ft. from W. Line

From telegram

Location -----

Rig up -----

Drilling and ~~Remarks:~~

*Top line 3412
Nlg 3465'*

RECORD

Cased ----- in., ----- ft.

Sand -----

Gas -----

Oil -----

Total Depth -----

PRODUCTION

1st 24 hrs. Nat. -----

1st 24 hrs. after shot -----

Gas ----- Cu. Ft.

Dry Hole -----

Abandoned -----

Date

10/12 1923 *M. A. Benson* Scout
Ry. F. Hill

Map No. ~~KANSAS~~ 1 Sec. 34 Twp. 33 R. 2E

Well No. 1 Ind

Platachee Oil Company

Contractor

ABANDONED SECTION PLAT

200 Ft. from N. Line
 _____ Ft. from S. Line
 _____ Ft. from E. Line
 200 Ft. from W. Line

0			

Location _____

Rig up _____

Drilling and Remarks:

2049
 3790'
 N.F.W.

RECORD

Cased _____ in., _____ ft.
 Sand _____
 Gas _____
 Oil _____
 Total Depth _____

PRODUCTION

1st 24 hrs. Nat. _____
 1st 24 hrs. after shot _____
 Gas _____ Cu. Ft.
 Dry Hole _____
 Abandoned _____

Date

NOV 24 1923

M. A. HENEAR Scout

Shannon
K1 KANSAS SEC. 34 TWP. 33S R. 2E

WELL NO. 1 Judd

Capt Jerrill COMPANY _____

CONTRACTOR _____

SECTION PLAT

ABANDONED

_____ FT. FROM N. LINE
_____ FT. FROM S. LINE
_____ FT. FROM E. LINE
_____ FT. FROM W. LINE

①			

ou

LOCATION _____

RIG UP _____

DRILLING AND REMARKS:

3410 20y line
3785 } H.D.N
3790 }

RECORD

CASED _____ IN. _____ FT.
SAND 3788-3790
GAS _____
OIL _____
TOTAL DEPTH 3790

PRODUCTION

1ST 24 HRS. NAT. _____
1ST 24 HRS. AFTER SHOT _____
GAS _____ CU. FT.
DRY HOLE
ABANDONED

DATE

11/15 192 3

SCOUT