

Russell

15

R.

13W ✓

Sec. 20 Twp.

Well No. #1 Sellens Farm

Jones, Shelborne & Farmer Company

Contractor


_____ Ft. from N. Line

990' _____ Ft. from S. Line

_____ Ft. from E. Line

990' _____ Ft. from W. Line

NE SW SW

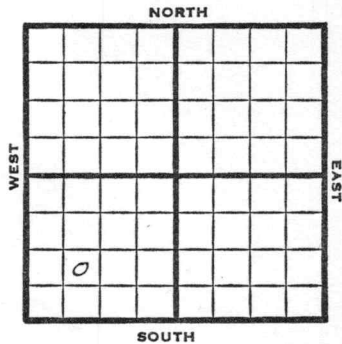

1950

Elev 1794

REPORT

4/26

Spud 4-20-50

Drlg. 420'

7/5

13" @ 435

10" @ 766

Anhy 772

8" @ 2510

Topeka 2690

Lans 2986

1 boph 2990-3005

7" @ 3085

FU 400' oil & hr

Arb 3248

TD 3260

FU 2000' oil

Comp 449 bopd

Completed

COMPLETED

Kansas

Map No. _____ Sec. 20 Twp. 15 R. 13W

Well No. 1 Sellens

Jones, Shelborne & Farmer Company

Contractor

NE SW SW

SECTION PLAT

0			

_____ Ft. from N. Line

990 Ft. from S. Line

_____ Ft. from E. Line

990 Ft. from W. Line

Russell County

Location _____

Rig up _____

Drilling and Remarks:

Spud 4-20-50

drlg. 420

RECORD

Cased _____ in., _____ ft.

Sand _____

Gas _____

Oil _____

Total Depth _____

PRODUCTION

1st 24 hrs. Nat. _____

1st 24 hrs. after shot _____

Gas _____ Cu. Ft.

Dry Hole _____

Abandoned _____

Date

APR 26 1950 19

J. E. TYRA

Scout

Kansas

Map No. _____ Sec. 20 Twp. 15 R. 13W

Well No. 1 Sellens

Jones-Shelborne & Farmer Company

Contractor

E1. 1794

NE SW SW

SECTION PLAT

_____ Ft. from N. Line

990 Ft. from S. Line

_____ Ft. from E. Line

990 Ft. from W. Line

0			

Russell County

Location _____

Rig up _____

Drilling and Remarks:

13" @ 435
 10" @ 766
 Anhy 772
 8" @ 2510
 Topeka 2690
 Lans. 2986
 1 boph 2990-3005
 7" @ 3085

RECORD

Cased _____ in., _____ ft.

Sand _____

Gas _____

Oil _____

Total Depth 3260

PRODUCTION

1st 24 hrs. Nat. _____

1st 24 hrs. after shot _____

Gas _____ Cu. Ft.

Dry Hole _____

Abandoned _____

Date

JUL 5 1950

J. E. TYRA Scout

FU 400' oil 1 hr.

Arb. 3248

TD 3260

FU 2000' oil

Comp. 449 bopd

JUL 7 1950

Scout Cards
Land Small Map
Land Wall Map
Tracings
France Map
Pierce Map
Misc.

7/7

3500
ONE
DWA
SAND
BASED

RECORD

SECTION 16.41

Contract

Company

Location

Map No

Scale