

501 S. Valley - KCK


16 - 115 - 25E

27-F-30

MISSOURI GEOLOGICAL SURVEY AND WATER RESOURCES - ROLLA, MO.

COUNTY _____ LOG NUMBER _____
 COMPANY OR OWNER Carswell, Firman L., Mfg Co
 FARM _____ WELL NO. 1
 LOCATION _____ SEC. 16 T. 11S R. 25E
 CONTRACTOR Ed Feyh
 DRILLER _____
 COMMENCED _____ COMPLETED 1939
 PRODUCTION _____ PLOTTED _____

 WATER RECORD _____
 SOURCE OF LOG Dr. H. Merc original
 REMARKS _____

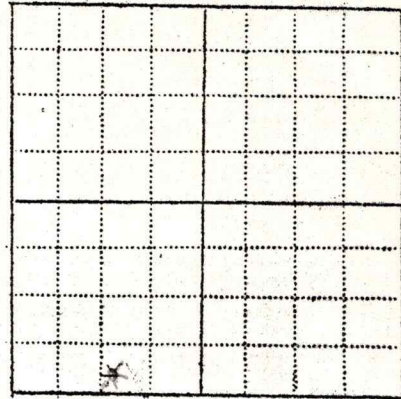

ELEV. _____
 TOTAL DEPTH _____
 CHEM. ANAL. NO. _____

FORMATION	THICK	DEPTH	FORMATION	THICK	DEPTH
Sand	0	65	Shale G	245	264
Gray shale	65	87	Lime	264	269
Sand shale	87	147	Shale dark	269	274
Dark shale	147	153	Sand	279	274 1/2
Green S	153	157			
hard	157	162			
Lime	162	164	Packer set 267		
Green S	164	169	Pony packer set 260		
Red bed	169	175 1/2	68' 8" drive pipe		
Lime	176 1/2	180			
Light shale	180	195			
Green shale	195	211			
Lime	211	213			
Green shale	213	221			
Lime	221	226			
Blue shale	226	230			
Lime	230	233			
Slaty	233	234	Gas B.		
Shale	234	243			
Lime	243	248			