

17-11-25E

Plotted P.K.


Company

Sec. 17 T. 11 R. 25  
Loc.

Farm I-H Flour Mill No. 2

Total Depth 317'  
Comm.  
Shot or Treated  
Contractor  
Issued  
Comp.

County

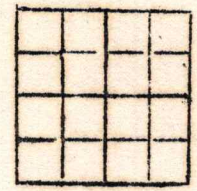

Casing

20 in. 10 in.  
15 1-2 8 1-4 74'  
12 1-2 6 5-8 245'  
13 3-8 5 3-16

Elevation

Production

Figures Indicate Bottom of Formation

Sand & clay	40'
Red sand	73
Light shale	83
Blue shale	103
Sandy shale	150
Water at 135'	
Blue shale	170
Sand	175
Sandy shale	185
Red shale	187
Lime	200
Shale	202
Lime	205
Shale	240
Lime	244
Shale	249
Lime	256
Blue shale	258
Shale	275
Lime	281
Blue shale	285 Gas, coal & water
Oil sand	292
Shale	311
Shale	313
Black shale	317 and gas

Sum. 3-20-1930


#2

I-H. F. ...

Plant

Sec. 17 Tp. 11 25E

Map No. Well No. 2

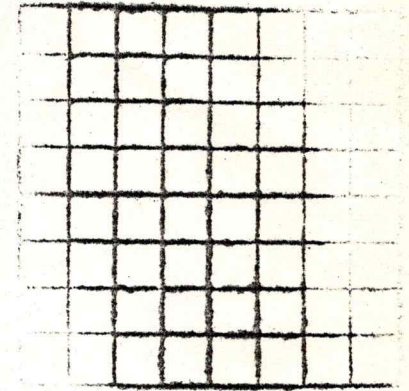

Wyanadale ls

Kan

TD 317

watered 17 1/2 ft

40 Sand & clay	40
33 River Sand	73
14 light blue	83
2 blue shale	103
47 Sandy shale	150
20 blue shale	170
5 Sand	175
10 Sand, shale	185
2 Red shale	187
13 L ---	200
2 Shale	202
3 L ---	205
35 Shale	240
4 L ---	244
5 Shale	249
7 L ---	256
3 Blue shale	258
17 Shale	275
6 L ---	281
4 Black shale	285
7 Oil sand	292
17 Shale	311
x 31 ---	313
4 Black Shale	317

6" (approx) w 24 1/2'

gas low breather

low gas

From

Rammond Bradford

K.C. Mo

From Ramond Bradford?

K.C., Mo