


Butler

Form 51-5M-5-34-Palace

Map No. **KANSAS** Sec. 8 Twp. 27 R. 6E

Well No. 1 *Brissey* Farm  
*Richmond Oly* Company

NORTH

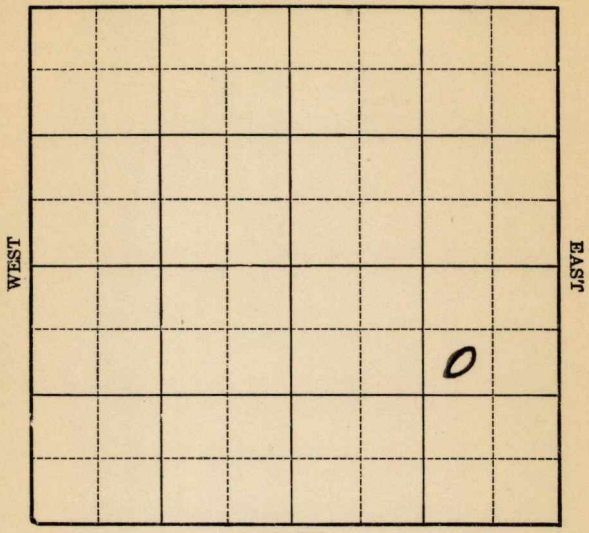

SOUTH

Location \_\_\_\_\_  
Drilling Remarks \_\_\_\_\_

Rig Up \_\_\_\_\_  
Drilling Remarks \_\_\_\_\_

\_\_\_\_\_

\_\_\_\_\_

**RECORD**

**PRODUCTION**

Cased \_\_\_\_\_ in. \_\_\_\_\_ ft.

Sand \_\_\_\_\_

Gas \_\_\_\_\_

Oil \_\_\_\_\_

Total Depth \_\_\_\_\_

1st 24 hrs. Nat. \_\_\_\_\_

1st 24 hrs. after shot \_\_\_\_\_

Gas \_\_\_\_\_ cu. ft.

Dry Hole \_\_\_\_\_

Abandoned \_\_\_\_\_

Butler

Map No.            Sec. 8 Twp. 27 R. 6<sup>E</sup>


Well No. 1 Brieseg Farm  
Richmond Sdg. Company

990 Ft. from N. Line

\_\_\_\_\_ Ft. from S. Line

990 Ft. from E. Line

\_\_\_\_\_ Ft. from W. Line

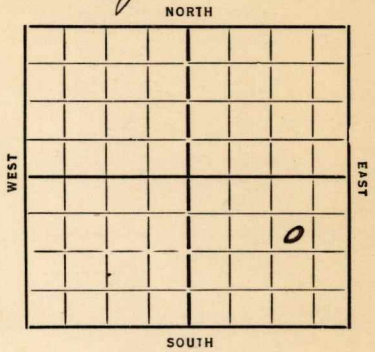

Date

REPORT

1934  
 11/7 Rig  
 11/15 Rig  
 11/22 Spud  
 11/28 \_\_\_\_\_  
 12/6 Sdg 1365 12" 735  
 12/18 " 2300  
 12/21 — 12/27 — 1/3/35 —  
 1/10 Lansing 2764 6" 2764  
 BML 3085 Sdg 3100  
 1/16 3226 HFW  
 1/24 — 1/31 — 2/7 —  
 2/13 Line 2764 TD 3226  
 PA 2770 90lb 70 Water.

COMPLETED

Map No. 11 Sec. 8 Twp. 27 R. 6E

Well No. 1-Brisey

Richmond Oil Company

Contractor

FIRST REPORTS

SECTION PLAT

990 Ft. from N. Line

\_\_\_\_\_ Ft. from S. Line

990 Ft. from E. Line

\_\_\_\_\_ Ft. from W. Line

			0

Location \_\_\_\_\_

Rig up \_\_\_\_\_

Drilling and Remarks:

Rig

RECORD

Cased \_\_\_\_\_ in., \_\_\_\_\_ ft.

Sand \_\_\_\_\_

Gas \_\_\_\_\_

Oil \_\_\_\_\_

Total Depth \_\_\_\_\_

PRODUCTION

1st 24 hrs. Nat. \_\_\_\_\_

1st 24 hrs. after shot \_\_\_\_\_

Gas \_\_\_\_\_ Cu. Ft.

Dry Hole \_\_\_\_\_

Abandoned \_\_\_\_\_

Date

11-7-34 19

ORVAL MANN SCHRECK

Scout

KANSAS

Map No. 11 Sec. 8 Twp. 27 R. 6E

Well No. 1-Brissay

Richmond Drly Company

Contractor

COMPLETED

SECTION PLAT

990 Ft. from N. Line

..... Ft. from S. Line

990 Ft. from E. Line

..... Ft. from W. Line

			0

Location.....

Rig up.....

Drilling and Remarks:

P.B. 2770

9 oil  
70 water

RECORD

Cased..... in., ..... ft.

Sand line 2764

Gas.....

Oil.....

Total Depth 3226

PRODUCTION

1st 24 hrs. Nat.....

1st 24 hrs. after shot.....

Gas..... Cu. Ft.

Dry Hole.....

Abandoned.....

Date

ORVAL MANNSCHRECK

2-13-35 192.....

Scout