


17-11-25E *noted PK*

Company
Farm I+H Flour Mill No. 3
Total Depth 320'
Comm. 3-10-30
Shot or Treated
Contractor
Issued

Sec. 17 T. 11 R. 25
Loc.

County Wyandotte

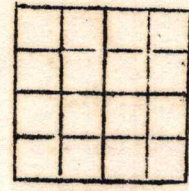

Casing
20 in. 10 in.
15 1-2 8 1-4
12 1-2 6 5-8 236'
13 3-8 5 3-16

Elevation
Production

Figures Indicate Bottom of Formation


Sand	75'
Light shale	110
Sandy shale	150
Blue shale	165
White shale	175
Blue shale	180
Red shale	183
Lime	198
Blue shale	230
Shale	235
Lime	242
Shale	245
Lime	247
Blue shale	260
Lime	268
Blue shale	280
Lime	285
Black shale, coal, slate & shale	290 gas
Oil sand	295
Shale	312
Limestone	316
Black shale & coal	320 gas

75 Sand 75
 35 light sh 110
 40 Sandy sh 150
 15 Blue sh 165
 10 white sh 175
 5 Blue sh 180
 3 Red sh 183
 15 1 — 198
 34 Blue sh 230
 5 Sh 235
 7 1 — 242
 3 Sh 245
 2 1 — 247
 13 Blue sh 260
 8 1 — 268
 12 Blue sh 280
 5 1 — 285
 5 clay, sand, sh & ester 290
 5 Oil sand 295
 17 Sh 312
 4 limestone 316
 4 Black sh & coal 320

Wagonville Co
 Russ Sand Mass

3
 I-H. Flour Mill

Sec. 17 Tp. 11 R. 25E
 Map No. Well No. 3

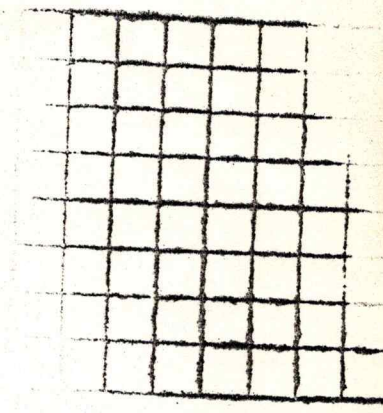

I H Flour Mill

Sec 17 - T 11 - R 25 E

gas

From Raymond Bradford
 K. C. Mo

From Raymond (Bradford) Bradford
 K. C. Mo (?)