

# KANSAS

Cowley


FORM 51 5M 4-41 PETROL

Section 14 Township 32 Range 5-E

Well No. #3 ~~#1~~ Miller "A"

Company B. B. Blair

NORTH Frog Hollow Pool

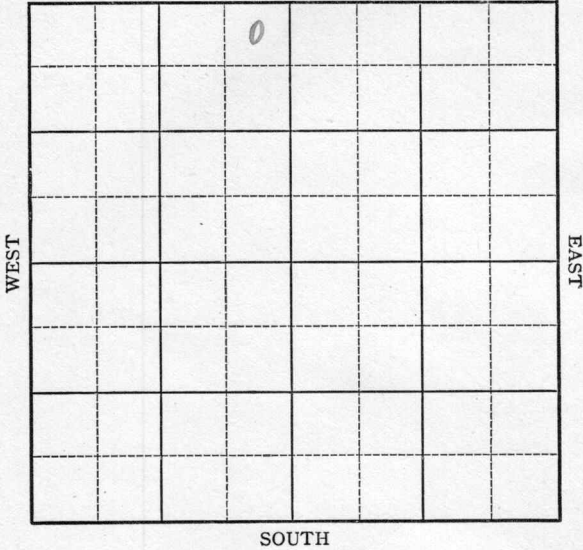

SOUTH



KANSAS

Map No. 2 Sec. 14 Twp. 32 R. 5E

Well No. 1 Miller "A"

B. B. Blair Company

FIRST REPORT Contractor

NE NW

SECTION PLAT

330 Ft. from N. Line

\_\_\_\_\_ Ft. from S. Line

330 Ft. from E. Line

\_\_\_\_\_ Ft. from W. Line

		0	

FROG HOLLOW POOL

Location \_\_\_\_\_

Rig up \_\_\_\_\_

Drilling and Remarks:

Surface Hole

RECORD

Cased \_\_\_\_\_ in., \_\_\_\_\_ ft.

Sand \_\_\_\_\_

Gas \_\_\_\_\_

Oil \_\_\_\_\_

Total Depth \_\_\_\_\_

PRODUCTION

1st 24 hrs. Nat. \_\_\_\_\_

1st 24 hrs. after shot \_\_\_\_\_

Gas \_\_\_\_\_ Cu. Ft.

Dry Hole \_\_\_\_\_

Abandoned \_\_\_\_\_

Date

JUN 3 1942 19 \_\_\_\_\_

S. J. LEWIS Scout

Cowley KANSAS

Map No. 2 Sec. 14 Twp. 32 R. 5E

Well No. 3 Miller "A"

B. B. Blair Company

**CORRECTION** Contractor

NE NW


330 Ft. from N. Line

\_\_\_\_\_ Ft. from S. Line

330 Ft. from E. Line

\_\_\_\_\_ Ft. from W. Line

SECTION PLAT

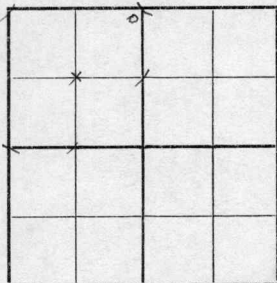

FROG HOLLOW POOL

Location \_\_\_\_\_

Rig up \_\_\_\_\_

Drilling and Remarks:

Reported as i

#1 Miller "A"

RECORD

Cased \_\_\_\_\_ in., \_\_\_\_\_ ft.

Sand \_\_\_\_\_

Gas \_\_\_\_\_

Oil \_\_\_\_\_

Total Depth \_\_\_\_\_

PRODUCTION

1st 24 hrs. Nat. \_\_\_\_\_

1st 24 hrs. after shot \_\_\_\_\_

Gas \_\_\_\_\_ Cu. Ft.

Dry Hole \_\_\_\_\_

Abandoned \_\_\_\_\_

Date

JUN 10 1947

19

S. J. LEWIS

Scout

Cowley

Map No. 2 Sec. 14 Twp. 32 R. 5E

Well No. 3 Miller "A"

B. B. Blair Company

**ABANDONED** Contractor

SECTION PLAT

NE NW

330 Ft. from N. Line

\_\_\_\_\_ Ft. from S. Line

330 Ft. from E. Line

\_\_\_\_\_ Ft. from W. Line


FROG HOLLOW POOL

RECORD

Location \_\_\_\_\_

Cased \_\_\_\_\_ in., \_\_\_\_\_ ft.

Rig up \_\_\_\_\_

Sand \_\_\_\_\_

Drilling and Remarks:

Gas \_\_\_\_\_

*Bar 3019*

Oil \_\_\_\_\_

Total Depth 3025

*5" @ 3032*

*809 to 3044 - 56*

*No. holes*

PRODUCTION

1st 24 hrs. Nat. \_\_\_\_\_

1st 24 hrs. after shot \_\_\_\_\_

Gas \_\_\_\_\_ Cu. Ft.

Dry Hole \_\_\_\_\_

Abandoned \_\_\_\_\_

Date

JUN 24 1942 19

S. J. LEWIS Scout