

20-11-25E Plotted
 G.E.F.
 card made out

K. C. STRUCTURAL STEEL CO.
 K.C.Structural Steel Co. No. 1.


SEC. 20 T. 11 R.25E

21st & Metropolitan

County. Wyandotte

Total Depth. 440'
 Comm. 7-22-29 Comp. 7-27-29
 Shot or Treated.
 Contractor. J.D.Judd & Co.
 Issued. 10-29-38

OCT 29 1938

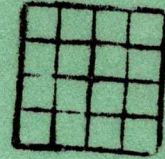

CASING:
 8 1/4" 235'
 6 5/8" 310'

Elevation.

Production. Dry

Figures Indicate Bottom of Formations.

fill in		9
sand	wtr	74
shale blue		75
wtr sand - strong		82
shale blue		90
sand		95
shale blue		145
sdv shale lt		150
sand	-sh oil-	155
shale lgt		160
shale red		168
sand		180
shale lgt		203
lime grey		220
lime brown		229
shale lgt		234
reduced from 8 to 6 1/4		
lime grey		243
oil sand	oil show	248
shale dk		257
lime grey	IM 265	262
shale blk		264
63,000 gas		
oil sand		275
showing oil & wtr		
shale lgt		294
lime		296
slate blk	wtr	300
SIM 300		
sdv shale lgt		324
sand grey		328
shale sdv		340
sand brown sft		360
showing oil		
sand white		370
water strong		
sand brown		380
sand white		390
shale lgt		392
sand white-wtr stronger		420
sand & slate		425
sand white		433
shale white		440
Total Depth		

80

7/27/1929


KC Structural Steel

do
20-11S-25E

J.D. Judd
#1

9 Fill in	9
65 Sand	74 water 35 ft
1 Blue Shale	75
1 Water Sand	82 water strong
7 Blue Shale	90
5 Sand	95
50 Blue Shale	145
5 Lt Sandy shale	150
5 Sand	155 showing oil
5 Lt shale	160
7 Shale	165
12 Sand	180
23 Lt shale	203
11 Gray Lime	220
1 Brown lime	229
6 Lt shale	235 Reduc of frame 2 to 6 ft at 235 ft
2 Gray Lime	243
50.15 Sand	248 showing oil
10 Dark Shale	257
5 Gray Lime	262 L.A. 205 V.M. V
2 Dark shale	264 Gas 63000
4 Oil sand	275 showing oil & water
17 Lt shale	294
2 Lime	296
4 Lt shale	300 water SAM 300
24 Lt Sandy shale	324
4 Gray sand	328
12 Lt shale	340
10 Brown sand	360 showing oil
Oil	370 water strong
10 white sand	380
10 Brown sand	390
2 Lt shale	392
28 white sand	420 water stronger
5 sand shale	425
7 white sand	433
7 white shale	440 TD Dry hole
2 1/2 Play at	235 ft
6 1/2	310

21st & Metropolitan Ave
KCKs

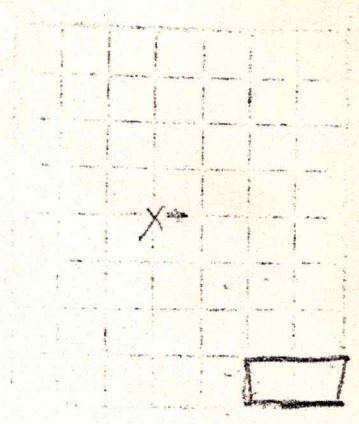

18 1/2
Ch 73

From
J.D. Judd
Mar 27, 1930