


Section 14 Township 32 Range 5-E

Well No. #4 Rube Miller "A"

Company B. E. Blair & Continental

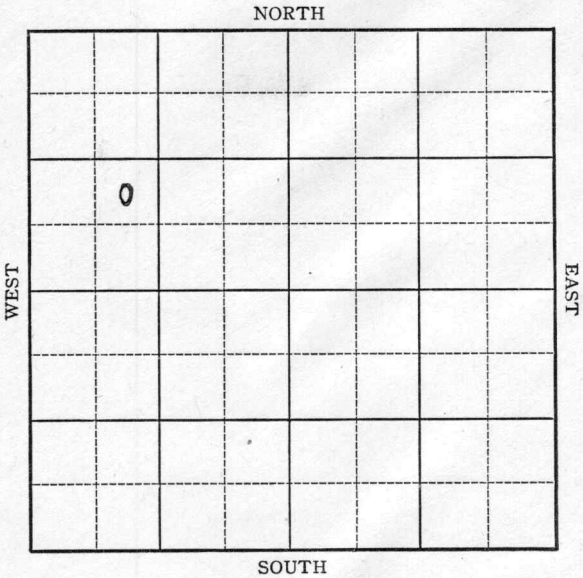

Sec. 14 Twp. 32 R. 5-^W

Well No. #4 Rube Miller "A" Farm

B. B. Blair "Continental" Company

Miscellaneous


_____ Ft. from N. Line

990 Ft. from S. Line

_____ Ft. from E. Line

990 Ft. from W. Line

Elev. 1344

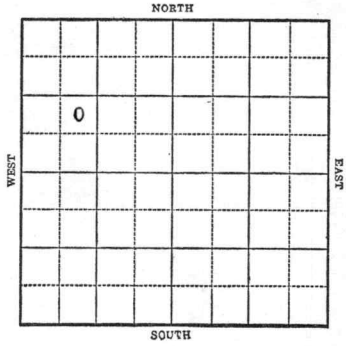

1943

R E P O R T

7/7

Rotary

7/15

8" @ 96
Drlg. 1105'

7/21

5" @ 3014
T.D. 3051
RUST

7/28

Bart 3047-90 T.D.
30Dqts 3070-90
2700' oil

8/4

" "

8/11

Bart 3047
5" @ 3014
30 qts 3070-90
Pump 147 Pot.
T.D. 3090'
Grav. 368

COMPLETED

KANSAS

Map No. 2 Sec. 14 Twp. 32 R. 5E

Well No. 4 Rube Miller "A"

B. B. Blair & Continental Company

FIRST REPORT

Contractor

NE SW NW

SECTION PLAT

_____ Ft. from N. Line

990

_____ Ft. from S. Line

_____ Ft. from E. Line

990

_____ Ft. from W. Line

o			

MISCELLANEOUS

Location _____

Rig up _____

Drilling and Remarks:

Rotary

RECORD

Cased _____ in., _____ ft.

Sand _____

Gas _____

Oil _____

Total Depth _____

PRODUCTION

1st 24 hrs. Nat. _____

1st 24 hrs. after shot _____

Gas _____ Cu. Ft.

Dry Hole _____

Abandoned _____

Date

JUL 7 1943

19

S. J. LEWIS

Scout

Cowley

Map No. **KANSAS** Sec. 14 Twp. 32 R. 5E

Well No. 4 Rube Miller "A"

B. B. Blair & Continental Company

COMPLETED Contractor

NE SW NW

SECTION PLAT

_____ Ft. from N. Line

990 Ft. from S. Line

_____ Ft. from E. Line

990 Ft. from W. Line

MISCELANEOUS

Location _____

Rig up _____

Drilling and Remarks:

Bar Y3047
5" @ 3014
309 to 3070-90
Pump 147
36 E 9

RECORD

Cased _____ in., _____ ft.

Sand _____

Gas _____

Oil _____

Total Depth 3090

PRODUCTION

1st 24 hrs. Nat. _____

1st 24 hrs. after shot _____

Gas _____ Cu. Ft.

Dry Hole _____

Abandoned _____

Date

AUG 1 1 1943 19

S. J. LEWIS Scout