

KANSAS

FORM 51 5M 10-41 PETROL


Cowley

Section 15 Township 32 Range 5-E

Well No. 1 Coffman

Company Blair & Rooney

NORTH Frog Hollow Pool

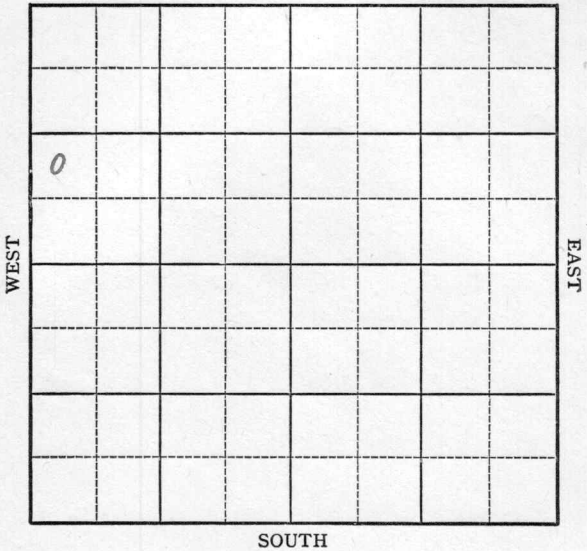

Sec. 15 Twp. 32 R. 5-E

Well No. #1 Coffman Farm

Blair & Rooney Company

(Frog Hollow)


_____ Ft. from N. Line

990 Ft. from S. Line

_____ Ft. from E. Line

330 Ft. from W. Line

Elev. 1344

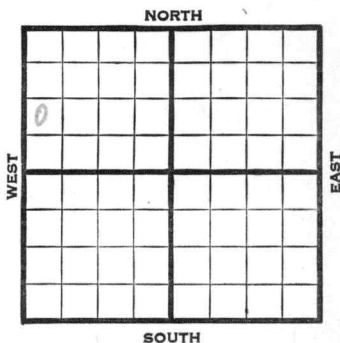

1941	REPORT
12/23	Location
12/31	Spud.
1942	
1/8	8" - 150' WOC.
1/15	Dr lg. 1255'
1/22	SD 2575'
1/29	"
2/5	"
2/12	"
2/19	Dr lg. 3010'
2/26	Miss. 3146' 5" - 3070'
	Shut down.
3/4	Miss. 3146'
	T.D. 3160'
	No shows.
	' ABANDONED

Map No. 2 Sec. 15 Twp. 32 R. 5E

Well No. 1 Coffman

Blair & Rooney Company
ABANDONED

Contractor

NW SW NW

SECTION PLAT

_____ Ft. from N. Line

990 Ft. from S. Line

_____ Ft. from E. Line

330 Ft. from W. Line

D			

FROG HOLLOW POOL

Location _____

Rig up _____

Drilling and Remarks:

Miss 8146
No shows

RECORD

Cased _____ in., _____ ft.

Sand _____

Gas _____

Oil _____

Total Depth 3/60

PRODUCTION

1st 24 hrs. Nat. _____

1st 24 hrs. after shot _____

Gas _____ Cu. Ft.

Dry Hole _____

Abandoned _____

Date

MAR 4 1942 19

S. J. LEWIS Scout