

Cowley

Form 51-5M-5-34-Palace


Map No. _____ Sec. 16 Twp. 32 R. 5E

Well No. 2 Garden (Gardner) Farm

J. Soolby

Company

NORTH

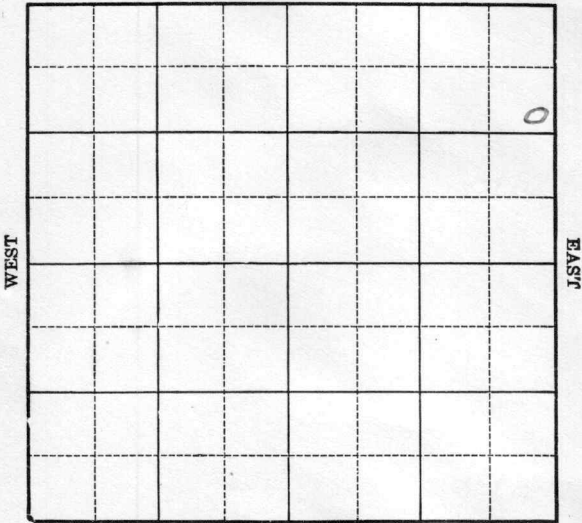

SOUTH

Location _____

Drilling Remarks _____

Rig Up _____

Drilling Remarks _____

RECORD

Cased _____ in. _____ ft.

Sand _____

Gas _____

Oil _____

Total Depth _____

PRODUCTION

1st 24 hrs. Nat. _____

1st 24 hrs. after shot _____

Gas _____ cu. ft.

Dry Hole _____

Abandoned _____

Cowley

Map No. KANSAS Sec. 16 Twp. 32 R. 5E

Well No. 2 Gardner Farm


J. Sooby Company

1200 Ft. from N. Line

_____ Ft. from S. Line

500 Ft. from E. Line

_____ Ft. from W. Line

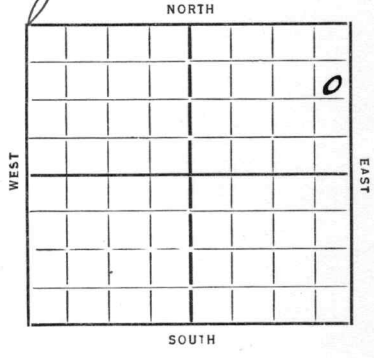

Date 1934

REPORT

11/14 Sand 715-32 T1) 732
49,000 lbs 175# R.P.

FIRST REPORTS



COMPLETED

KANSAS

Map No. 2 Sec. 16 Twp. 32 R. 5E

Well No. 2 - Gardner

J. Sooby Company

Contractor

FIRST REPORTS

COMPLETED

1200 Ft. from N. Line

_____ Ft. from S. Line

500 Ft. from E. Line

_____ Ft. from W. Line

SECTION PLAT

			●

Location _____

Rig up _____

Drilling and Remarks:

Sand 715-3'2

49,000 gas

175 lbs R.P.

RECORD

Cased _____ in., _____ ft.

Sand _____

Gas _____

Oil _____

Total Depth 732

PRODUCTION

1st 24 hrs. Nat. _____

1st 24 hrs. after shot _____

Gas _____ Cu. Ft.

Dry Hole _____

Abandoned _____

Date

11-14-34 19

ORVAL MANNSCHRECK

Scout