

KANSAS

Cowley

Section 16 Township 32 Range 5E

Well No. 1 Gardner

Company A.R. Jones et al

Misc.

NORTH

				0			

WEST

EAST

SOUTH

Cowley KANSAS ✓

Sec. 16 Twp. 32 R. 5E

Well No. #1 Gardner Farm

A. R. Jones etal Company


Miscellaneous (Uhl, Cont.)

400' Ft. from N. Line

_____ Ft. from S. Line

_____ Ft. from E. Line

200' Ft. from W. Line

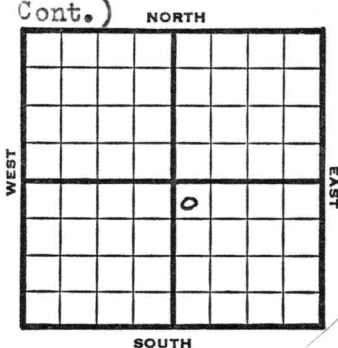

NW SE

1949 Elev 1335' REPORT

7/13 8" @ 103'
Drlg. 1227'

7/20 Drlg 2878'

7/27 Bart 3047'
5" @ 3052'
TD 3107'
40 qts 3068-84
CO

8/3 TD 3107'
Bart 3047'
5" @ 3052'
40 qts
Pump 30 Oil Pot
40° Gr.
Comp

COMPLETED

Map No. _____ Sec. 16 Twp. 32 R. 5E

Well No. 1 Gardner

A. R. Jones et al. Company

Uhl Contractor

NW SE

**FIRST REPORT
SECTION PLAT**

400 Ft. from N. Line

_____ Ft. from S. Line

_____ Ft. from E. Line

200 Ft. from W. Line

		o	

Cowley County

Location _____

Rig up _____

Drilling and Remarks:

8" @ 103

drlg. 1227

RECORD

Cased _____ in., _____ ft.

Sand _____

Gas _____

Oil _____

Total Depth _____

PRODUCTION

1st 24 hrs. Nat. _____

1st 24 hrs. after shot _____

Gas _____ Cu. Ft.

Dry Hole _____

Abandoned _____

Date

JUL 13 1949

19

S. J. LEWIS

Scout

Kansas

Miscellaneous

Map No. K2 Sec. 16 Twp. 32 R. 5E

Well No. 1 Gardner

A. E. Jones et al. Company

COMPLETE

Contractor

NW SE

E. J. Lewis

SECTION PLAT

400 Ft. from N. Line

_____ Ft. from S. Line

_____ Ft. from E. Line

200 Ft. from W. Line

		o	

Cowley County

Location _____

Rig up _____

Drilling and Remarks:

Bar 3047

5" @ 3052

409 to

Bring soil out

40° SW

RECORD

Cased _____ in., _____ ft.

Sand _____

Gas _____

Oil _____

Total Depth 3107

PRODUCTION

1st 24 hrs. Nat. _____

1st 24 hrs. after shot _____

Gas _____ Cu. Ft.

Dry Hole _____

Abandoned _____

Date

AUG 3 1949 19

S. J. LEWIS Scout