


O.W.W.O. Section 31 Township 13 Range 15 W KANSAS

Well No. # 1 Polcyn

Company Shields O.I. Prod.
Heathman

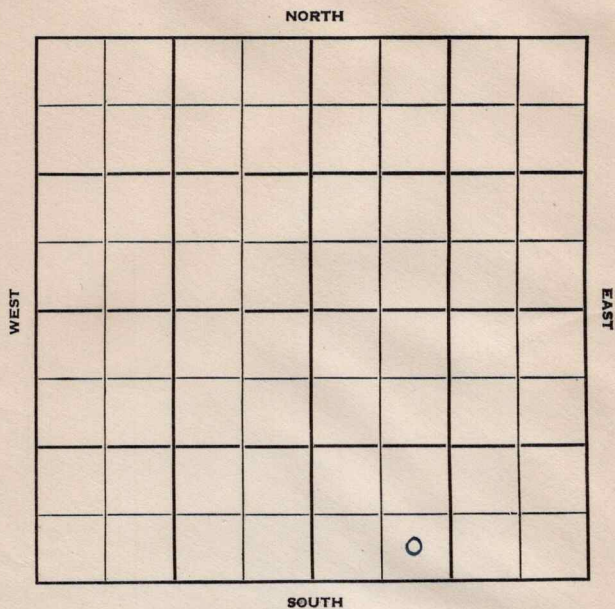

Russell

KANSAS

Sec. 31 Twp. 13 R. 15 W ✓

Well No. # 1 Polcyn Farm

Shields Oil Prod.

Heathman

Company

Heathman

Contractor

Ft. from N. Line

330


Ft. from S. Line

Ft. from E. Line

990

Ft. from W. Line

SE SW SE

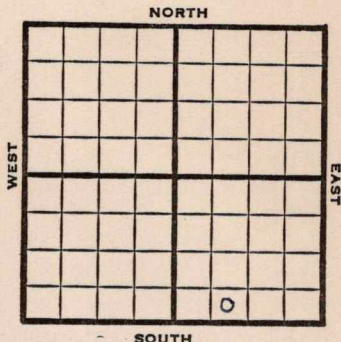

1951

Elev. 1890'

REPORT

9/19

Spud 9-9-51

8" @ 281'

Top 2786'

Heeb 3006'

Lans. 3054'

Drlg. 3139'

9/26

Spud 9-9-51

D&A TD 3314

8" @ 281'

Top 2786'

Heeb. 3006'

Lans. 3054'

Granite 3307'

Cored 3308-114 TD

D&A

ABANDONED

1955
3/9

O.W.W.O.

SWD well TD 3314' Lans 3054

PreCamb 3307 OTD 3314 CO

4" @ 3215 12/3133-43 100/3149-61

3000 A Comp. SWD well.

FIRST REPORT


ABANDONED

County Russell State Kansas
 Sec. 31 (Blk. Twp.) 13 (Sur. Rge.) 15W Map No.

Operator Heathman

Well No. 1 Farm Polcyn

Elev. 1890 Location SE SW SE

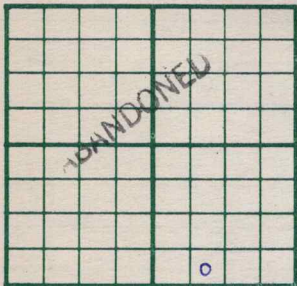

330 Ft. From S Line SE

990 Ft. From W Line Quarter

Ist. Report

Completion SEP 26 1951

Remarks

Heathman - Contr.

Spudding Date 9-9-51

Drlg. Data D & A TD 3314

8" @ 281 Top. 2786 Heeb. 3006

Lans. 3054 Granite 3307 Cored 3308-14 TD

D & A

J. E. TYRA

FIRST REPORT
~~ABANDONED~~

330	Ft. From	S	Line	SE
990	Ft. From	W	Line	Quarter
1st. Report	MAR	9	1955	
Completion	MAR	9	1955	
Remarks	OWWO			
Spudding Date	O.W.W.O.			

Drlg. Data	SWD well	TD 3314
Lans. 3054	PreCamb. 3307	OTD 3314
CO 4" @ 3215	12/ 3133-43	100/ 3149-61
3000 A	Comp. SWD well	

FABEN GILSTRAP