

KANSAS


Russell

FORM 51 5M 2-38 TPCO.

Section 31 Township 13 Range 15-W


Well No. #1 Polcyn

Company K. F. Nelson et al

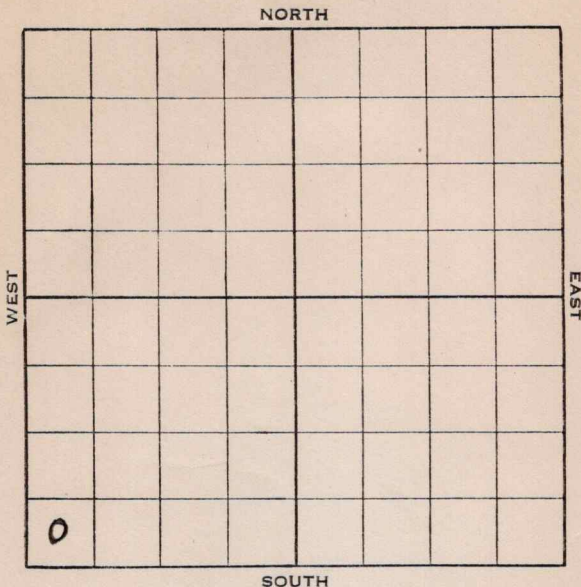

KANSAS

Russell

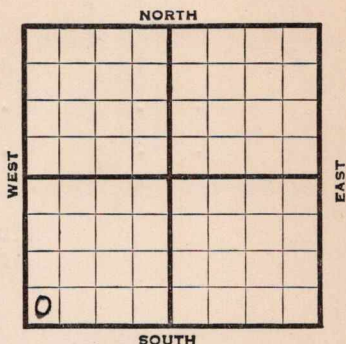Sec. 31 Twp. 13 R. 15-WWell No. #1 Polcyn FarmK. F. Nelson et al Company Ft. from N. Line330 Ft. from S. Line Ft. from E. Line330 Ft. from W. Line

	REPORT
1938	
11/9	Spud 200'.
11/18	15" - 399'. 12" - 600'.
	Ann ny . 968'. 10" - 984'.
	Drlg. 993'.
11/25	Dlg. 1900'.
12/2	Drlg. 2570'.
12/9	8" - 2570'. Topeka 2828'.
	T. D. 2855'. U. R. 8".
12/15	8" - 2855'. C. O.
12/23	Lans. 3103'. 8" - 3108'.
	T. D. 3185' S. O. S.D.O.
12/30	1/4 barrel oil & 2 B.W. 3188-91'.
	6" - 3112'. T. D. 3230' SD.
1939	
1/6	Cong. 3348'. Arb. 3369'?
	Drlg. 3377'. No Oil.
1/13	H. F. W. 3389-91'. T.D. 3393'.
	Will P. B.
1/20	P. B. 3164'. 6" - 3103'. WOC.
1/27	" " " " " "
	OVER

738025

1939

2/3 P. B. 3156'.
S. O. G & W.
Will treat.

2/8 Lans. 3103?
Arb. 3369'
H.F.W. 3389-93'.
T. D. 3393'.
P. B. to 3156'.
3000 acid.
Did not recover load.

ABANDONED

Russell

KANSAS

Map No. _____ Sec. 31 Twp. 13 R. 15WWell No. 1 PolcynK. F. Nelson etal Company

Contractor

FIRST REPORT

SW/C


____ Ft. from N. Line

330 Ft. from S. Line

____ Ft. from E. Line

330 Ft. from W. Line

SECTION PLAT

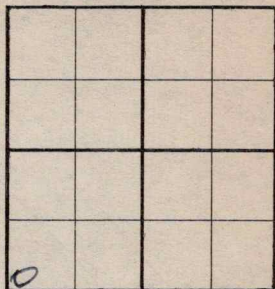

Location _____

Rig up _____

Drilling and Remarks:

Spud 200

RECORD

Cased _____ in., _____ ft.

Sand _____

Gas _____

Oil _____

Total Depth _____

PRODUCTION

1st 24 hrs. Nat. _____

1st 24 hrs. after shot _____

Gas _____ Cu. Ft.

Dry Hole _____

Abandoned _____

Date

NOV 9 - 1938 19

H. D. Hatfield Scout

Russell

KANSAS

Map No. _____ Sec. 31 Twp. 13 R. 15WWell No. 1 PolcynK. F. Nelson et al

Company

Contractor

ABANDONED

SW/C

_____ Ft. from N. Line

330 Ft. from S. Line

_____ Ft. from E. Line

330 Ft. from W. Line

WILDCAT

SECTION PLAT

Location _____

Rig up _____

Drilling and Remarks:

LANS 3103?

Arb 3369 H.F.W. 3389-9370

P.B. 3156

3000 Acid

Did NOT Recover load

D+A

RECORD

Cased _____ in., _____ ft.

Sand _____

Gas _____

Oil _____

Total Depth 3393

PRODUCTION

1st 24 hrs. Nat. _____

1st 24 hrs. after shot _____

Gas _____ Cu. Ft.

Dry Hole _____

Abandoned _____

Date

FEB 8 1939¹⁹

H.D.H.

Scout

By Paul