


Section 31 Township 13 Range 15W

Well No. 2 Polcyn "A"

Company Shields Oil Producers

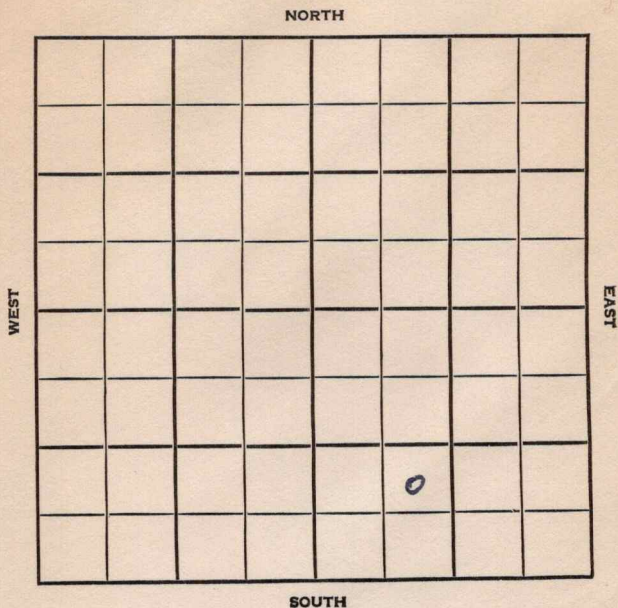

Russell

KANSAS


SEC.	TWP.	R.
31	13	15 W

WELL NO. # 2 Polcyn "A" FARM

COMPANY Shields Oil Producers

CONTRACTOR Co. tools
Gorham Pool

_____ Ft. from N. Line
 990 _____ Ft. from S. Line
 _____ Ft. from E. Line
 990 _____ Ft. from W. Line

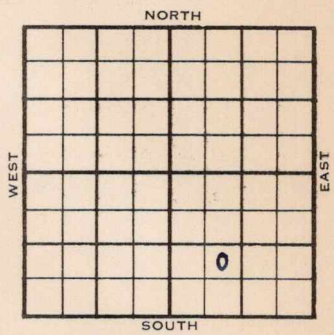

NE SW SE

	ELEVATION	REPORT
1955	1893'	
1/26	Spud 1-20-55 8" @ 215 Drlg. 2370'	
3/9	Spud 1-20-55 Oil Well TD 3317' 8" @ 215' Top 2791', Heeb 3012' Tor. 3032' Doug. 3046', Lans 3060' Gorham 3313' TD 3314' 5" @ 3314' DD 3317' S/ 34 bf 60% oil 12 hr. Comp 25 bopd.	

COMPLETED

County Russell State Kansas

Sec. 31 (Blk. 13) (Sur. 15W) (Twp. 13) (Rge. 15W) Map No.

Operator Shields Oil Producers

Well No. 2 Farm Polcyn "A"

Elev. 1893 Location NE SW SE

FIRST REPORT

990 Ft. From S Line SE

990 Ft. From W Line Quarter

1st. Report JAN 26 1955

Completion _____

Remarks _____

Co. tools

Spudding Date 1-20-55

Drlg. Data Gorham Pool

8" @ 215 drlg. 2370

FABEN GILSTRAP

