


KANSASSection 31 Township 13 Range 15WWell No. 1 PoleyCompany J.L. Drlg.

Gorham

NORTH

WEST

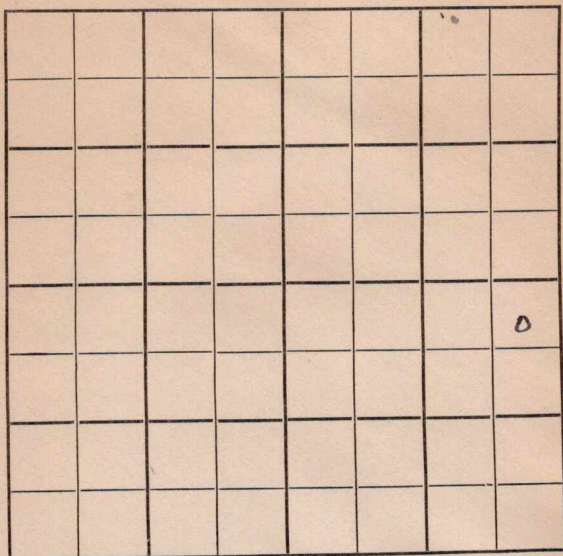

EAST

SOUTH

Russell **KANSAS**

Sec. 31 Twp. 13 R. 15W ✓

Well No. #1 Poleyn Farm

J. L. Drlg.

Gorham Pool (J. L. Drlg., Cont.) Company


330' Ft. from N. Line

 Ft. from S. Line

330' Ft. from E. Line

 Ft. from W. Line

NE SE

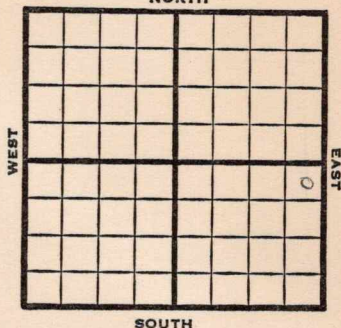

1949

Elev 1910'

R E P O R T

6/8

Location

6/15

"

6/21

8"@ 98'

Drlg 1675'

6/28

Drlg 3305'

7/6

TD 3342'

Lans 3082'

Gorham 3335'

Aband.

ABANDONED

Russell County Kansas State

Map No. _____ Sec. 31 Twp. 13 R. 15W

Well No. 1 Poleyn

J. L. Drlg. Company

J. L. Drlg. Contractor

NE SE

**FIRST REPORT
SECTION PLAT**

330 Ft. from N. Line

_____ Ft. from S. Line

330 Ft. from E. Line

_____ Ft. from W. Line

							o

Gornham Pool
Remarks:

Locaation

Date JUN 8 1949

Scout S. J. LEWIS

Kansas

Map No. K 72 Sec. 31 Twp. 13 R. 15WWell No. 1 Poleyn


J. L. Drlg.

Company

ABANDONED

Contractor

NE SE

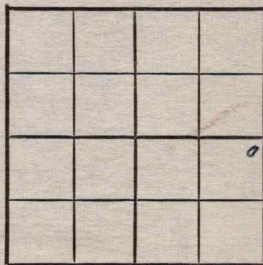E. 1910
SECTION PLAT330 Ft. from N. Line Ft. from S. Line330 Ft. from E. Line Ft. from W. Line

Russell County

Location Rig up

Drilling and Remarks:

Lease 3082Gorham 3335

RECORD

Cased in., ft.Sand Gas Oil Total Depth 3342

PRODUCTION

1st 24 hrs. Nat. 1st 24 hrs. after shot Gas Cu. Ft.Dry Hole Abandoned

Date

JUL 6 1949 19

S. J. LEWIS Scout