

Section 12 Township 27 Range 10-E

Company Hutchinson O&G

WEST

EAST

SOUTH

Greenwood

Sec. 12 Twp. 27 R. 10-E

Well No. #1 Wygle Farm


Hutchinson O & G _____ Company

Ft. from N. Line

1300 Ft. from S. Line

500 Ft. from E. Line

_____ Ft. from W. Line

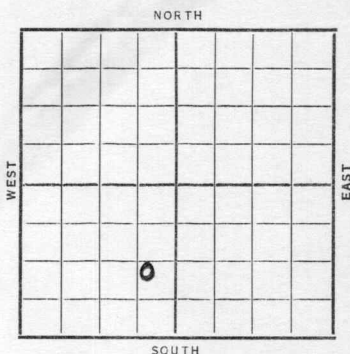

Date	REPORT
1938	
1/12	Spud.
1/20	12"-435' Drlg. 600
1/28	10" - 760' Drlg. 1150'.
2/4	Drlg. 1630'
2/11	Miss. 1880'. 6" @ 1885'.
	No shows.
2/16	6" @ 1885'.
	Miss. 1880'.
	T.D. 1902' S. W.
	P.B. 1900'.
	700' oil.
	1000 acid.
	Est. 35 bbls.
	COMPLETED

Map No. 9 Sec. 12 Twp. 27 R. 10EWell No. 1 WygleHutchinson O & G Company

Contractor

FIRST REPORT
NE SE SW Ft. from N. Line1300 Ft. from S. Line500 Ft. from E. Line Ft. from W. Line

SECTION PLAT

	0		

Location Rig up

Drilling and Remarks:

Spud

RECORD

Cased in., ft.Sand Gas Oil Total Depth

PRODUCTION

1st 24 hrs. Nat. 1st 24 hrs. after shot Gas Cu. Ft.Dry Hole Abandoned

Date

JAN 12 1938

19

H. D. Hatfield Scout

Greenwood KANSAS

Map No. 9 Sec. 12 Twp. 27 R. 10EWell No. 1 WygleHutchinson O & G

Company

Contractor

COMPLETED

NE SE SW

 Ft. from N. Line1300 Ft. from S. Line500 Ft. from E. Line Ft. from W. Line

SECTION PLAT

	0		

Location Rig up

Drilling and Remarks:

PB 1900700' oil1000 AcidEST 35 bbls

RECORD

Cased 6 in. 1885 ft.Sand MISS 1880Gas Oil Total Depth 1902 SW

PRODUCTION

1st 24 hrs. Nat. 1st 24 hrs. after shot Gas Cu. Ft.Dry Hole Abandoned

Date

FEB 16 193819H. D. Hatfield

Scout