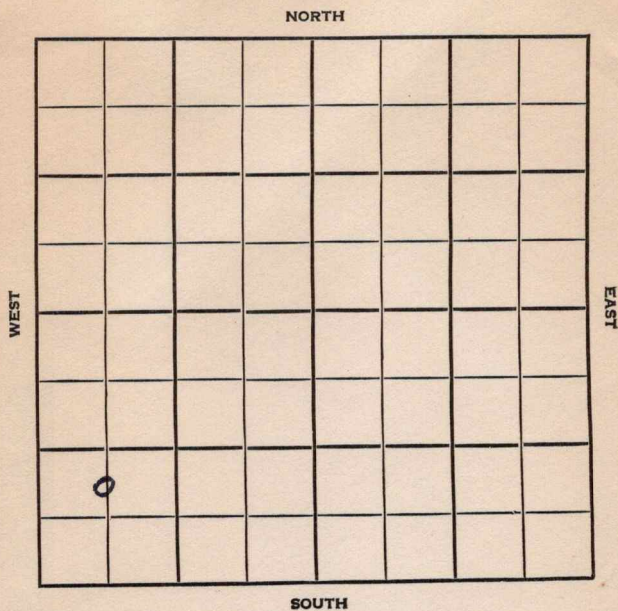


Section 32 Township 13 Range 15WWell No. 2 BaxterCompany Shields Oil Producers

Russell

KANSAS

SEC.	TWP.	R.
32	13	15 W

WELL NO.

2 Baxter

FARM

COMPANY

Shields Oil Producers

CONTRACTOR

Co. tools

Gorham Pool

Ft. from N. Line


990

Ft. from S. Line

Ft. from E. Line

660

Ft. from W. Line

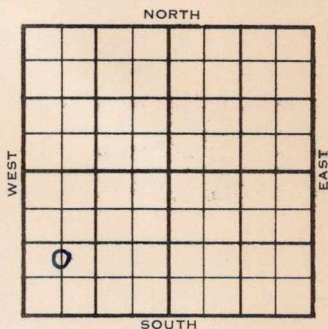C N $\frac{1}{2}$ SW SW

1955

ELEVATION

1898'

REPORT

1/26

RUST

3/30

Spud 1-24-55

D & A

TD 3361'

15 $\frac{1}{2}$ " @ 300'

10" @ 825'

lost hole.

skid 25' North

15 $\frac{1}{2}$ " @ 280'

12" @ 620'

Anhy 866'

10" @ 870'

Heeb. 3021' Dodge, 3049', Lans 3075'

Gorham 3327'

TD 3361'

Qtz 3360'

D & A

~~COMPLETED~~

ABANDONED

FABEN GILSTRAP

County Russell State KansasSec. 32 (Blk.
Twp.) 13 (Sur.
Rge.) 15W Map No. _____Operator Shields Oil ProducersWell No. 2 Farm BaxterElev. 1898 Location C N $\frac{1}{2}$ SW SW990Ft. From S Line SW660Ft. From W Line Quarter1st. ReportCompletion MAR 30 1955Remarks Gorham PoolCo. toolsSpudding Date 1-24-55Drlg. Data D & A TD 336115 $\frac{1}{2}$ " @ 300 10" @ 825 lost holeskid 25' north 15 $\frac{1}{2}$ " @ 280 12" @ 620Anhy 866 10" @ 870 Heeb. 3021Dodge 3049 Lans. 3075 Gorham 3327TD 3361 Qtz. 3360D & A

FABEN GILSTRAP