


Section 18 Township 19 Range 1W

Well No. #1 Anderson

Company Dozier Oil Co.

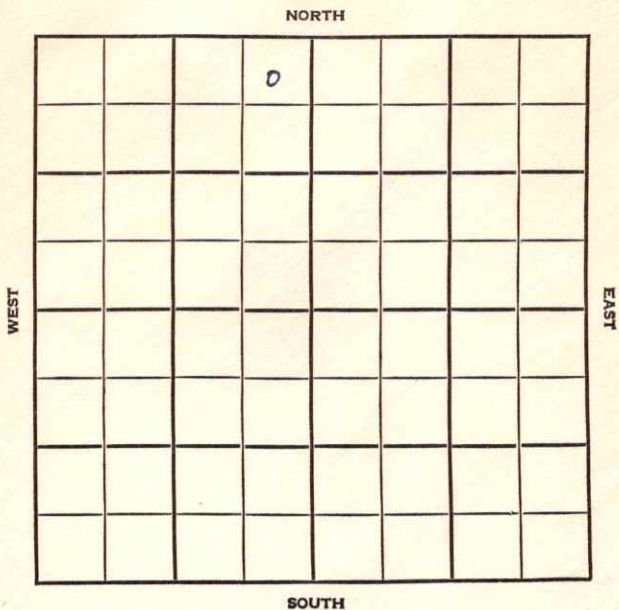

McPherson **KANSAS**

SEC. 18 TWP. 19 R. 1 W

WELL NO. # 1 Anderson FARM

COMPANY Dozier Oil Co.

CONTRACTOR Rocket tools

Jenday Ext. Pool


330 Ft. from N. Line

Ft. from S. Line

330 Ft. from E. Line

Ft. from W. Line

NE NE NW

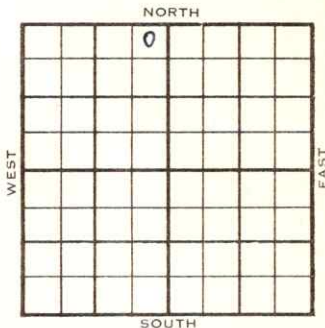

1954 ELEVATION 1573' RB 1570' DF REPORT

9/15 Spud 9-13-54
8" @ 160 w/? WOC

10/6 Spud 9-13-54
8" @ 160'
Lans 2344', Miss 2947'
TD 3017'
D & A **ABANDONED**

County McPherson State Kansas

Sec. 18 (Blk. 19 (Sur. 1W Map No. (Twp.) (Rge.)

Operator Dozier Oil

Well No. 1 Farm Anderson

Elev. 1573 RB Location NE NE NW
1570 DF

		0			

330 Ft. From N Line NW

330 Ft. From E Line Quarter

1st. Report

Completion OCT 6 1954

Remarks Jenday Ext. Pool

Rocket - Contr.

Spudding Date 9-13-54

Drlg. Data

8" @ 160 Lans. 2344 Miss. 2947

TD 3017

D & A

FABEN GILSTRAP