


SECTION 17 TOWNSHIP 19 RANGE 1W

WELL NO. #3 German

COMPANY Alfred Koehn, etal

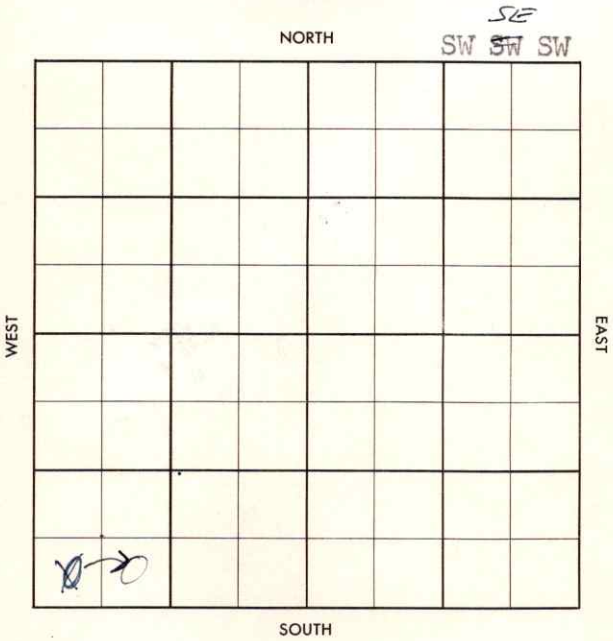

CORRECTION

FORM 513 SUNRAY

County McPherson Elev. 1577
 Sec. 17 Twp. 19 Rge. 1W
 Company Alfred Keesh etal
 Farm Name German No. 3

TOPS	DEPTH	LOG	DATUM	Loc. in Sec.
Anh.				SW SW SW SE
Tp.				
H.				
Tr.				
Dg.				
BL.				
L.				
K.C.				Geol. _____
B.K.C.				Contr. _____
Ce.				
C.			O	Meland Tls.
M.	2943			
M.				Pool
K.				Ritz-Canton
Mz.				
Ma.				
V.				
S.				
S.				
A.				COMPLETE
R.				
PE.				MAY 8 1957
G.				
TD.	2979			O

Date Comm. _____

Drlg. 750 APR 24 57 4-14-57
 5 1/2 2973 / MAY 1 57 O in no dye
 DD 2999 / 1/2 - \$ 6 Boph
 + 50 % wt Pol P. 25
 Boyd + 50 % wt

