


Map No. **KANSAS** Sec. 32 Twp. 13 R. 15W
Well No. 2 - J. A. Mermis Farm
Key & Pet et al Company

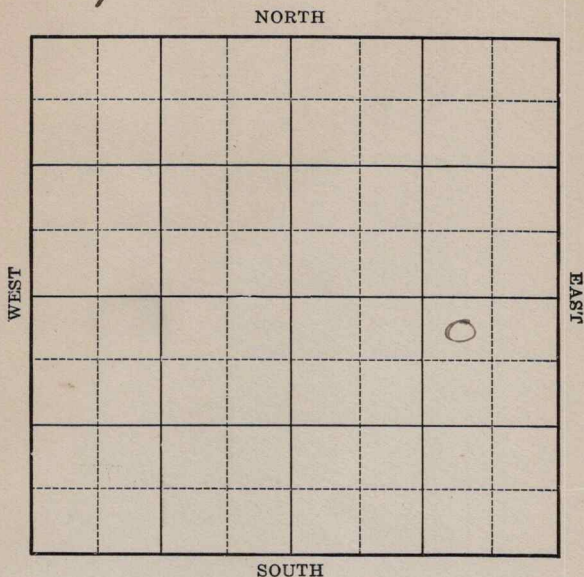

Location _____
Drilling Remarks _____

Rig Up _____
Drilling Remarks _____

RECORD

Cased _____ in. _____ ft.
Sand _____
Gas _____
Oil _____
Total Depth _____

PRODUCTION


1st 24 hrs. Nat. _____
1st 24 hrs. after shot _____
Gas _____ cu. ft.
Dry Hole _____
Abandoned _____

Map No. **KANSAS** Sec. 32 Twp. 13 R. 15WWell No. 2-J.A. Mermis Farm
Keys Pet et al Company330 Ft. from N. Line

_____ Ft. from S. Line

990 Ft. from E. Line

_____ Ft. from W. Line

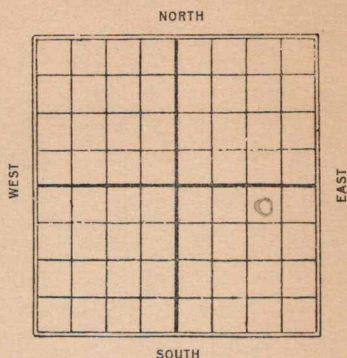1928

Date

REPORT

4/25 Cellar5/2 _____5/9 _____5/16 _____5/23 _____5/31 _____6/6 _____6/13 _____6/20 _____6/27 _____7/3 _____7/11 _____7/18 _____7/25 Rig8/1 Rigging up-8/7 Rigged up- S.D.8/15 _____8/22 _____9/5 _____9/12 T.D. - 400 lig tools.9/19 Drill 550'9/26 " 800'

10/3 - Drilg 935' 738/37
10/10 - " 1125'
10/17 " 1700'
10/24 - " 2355'
10/31 - T.D. 2575 - Run 8"
11/7 - VIR 8" 2750' T.D.
11/14 - Drilg 2780'
11/21 - " 2900'
11/28 - Top Oswald 3056'
show oil 3062 HFW
Drilg 3070'
12/5 - " 3190'
12/12 - 5" at 3290' Drilg 3306'
12/19 - drilg 3325'
12/26 - Gorham sand 3325-43
T.D. 3343'
pump in - 125 bbls
Sump lited

Map No. KANSAS Sec. 32 Twp. 12 R. 15W

Well No. 2 J. A. Morris

Keys Petroleum & Gas Co. Company

Contractor

SECTION PLAT

330 Ft. from N. Line

_____ Ft. from S. Line

990 Ft. from E. Line

_____ Ft. from W. Line

			0

FIRST REPORTS

Location _____

Rig up _____

Drilling and Remarks:

Cellar

RECORD

Cased _____ in., _____ ft.

Sand _____

Gas _____

Oil _____

Total Depth _____

PRODUCTION

1st 24 hrs. Nat. _____

1st 24 hrs. after shot _____

Gas _____ Cu. Ft.

Dry Hole _____

Abandoned _____

Date

APR 25 1928

192

S. J. LEWIS

Scout

Russell
Map No. **KANSAS** Sec. *32* Twp. *13* R. *15W*

Well No. *2 J. A. Mermis*

Keas P & Edel Company

Contractor

SECTION PLAT

330 Ft. from N. Line

..... Ft. from S. Line

990 Ft. from E. Line

..... Ft. from W. Line

COMPLETED

			0

Location.....

Rig up.....

Drilling and Remarks:

Graham Sand

3325 to 43

120 x 46 pump

RECORD

Cased..... in., ft.

Sand.....

Gas.....

Oil.....

Total Depth *3343*

PRODUCTION

1st 24 hrs. Nat.....

1st 24 hrs. after shot.....

Gas..... Cu. Ft.

Dry Hole.....

Abandoned.....

Date

DEC 26 1928

192

S. J. LEWIS

Scout