

KANSAS

Map No. _____ Sec. 32 Twp. 13 R. 15W

Well No. 1- J. a. merris Farm
Key & Ref Ital Company

NORTH

SOUTH

WEST

EAST

Location _____

Drilling Remarks _____

Rig Up _____

Drilling Remarks _____

RECORD

Cased _____ in. _____ ft.

Sand _____

Gas _____

Oil _____

Total Depth _____

PRODUCTION

1st 24 hrs. Nat. _____

1st 24 hrs. after shot _____

Gas _____ cu. ft.

Dry Hole _____

Abandoned _____

Map No. **KANSAS** Sec. 32 Twp. 13 R. 15W


Well No. 1 - J. A. Mermis Farm
Keays Petroleum Company

330 Ft. from N. Line

_____ Ft. from S. Line

330 Ft. from E. Line

_____ Ft. from W. Line

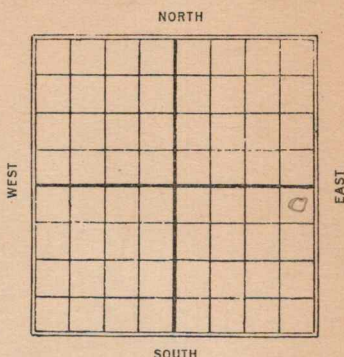

1928

Date

REPORT

4/25	Location
5/2	Rig
5/9	—
5/16	—
5/23	—
5/31	—
6/6	—
6/13	—
6/20	—
6/27	—
7/3	—
7/11	Rig up
7/18	—
7/25	Drilg 650
8/1	T.D. 806 - S.D. for pipe
8/7	T.D. 955 - S.D.
8/15	—
8/22	Drilg 2150'
9/5	No report
9/13	drilg 2825'
9/19	" 3058'
9/26	" 3270' show oil

10/3 - Ghoram sd 3314-17 ⁷³⁸¹⁴¹

50 to 60 bbls per hr.

10/10 - Gorkham sand

3314-17

swab 720 bbls per day

Comp.

Russell
No tracing
 MAP NO. **KANSAS** SEC. *32* TWP. *13* R. *15W*

WELL NO. *J. C. Mermis*

Hoys P. & Co. COMPANY

CONTRACTOR

SECTION PLAT

			0

330 FT. FROM N. LINE

FT. FROM S. LINE

330 FT. FROM E. LINE

FT. FROM W. LINE

COMPLETED

LOCATION _____

RIG UP _____

DRILLING AND REMARKS:

Graham Sand

3314-17

Boa King 720 x 80
a clay

RECORD

CASED _____ IN. _____ FT.

SAND _____

GAS _____

OIL _____

TOTAL DEPTH _____

PRODUCTION

1ST 24 HRS. NAT. _____

1ST 24 HRS. AFTER SHOT _____

GAS _____ CU. FT.

DRY HOLE _____

ABANDONED _____

DATE

OCT 10 1928

S. J. LEWIS

SCOUT

Map No. no Russell **KANSAS** Sec. 32 Twp. 13 R. 15W

Well No. J. A. MermisKeys P. & Co. Company

Contractor

SECTION PLAT

330 Ft. from N. Line

Ft. from S. Line

330 Ft. from E. Line

Ft. from W. Line

			0

FIRST REPORTS

Location ✓

Rig up

Drilling and Remarks:

RECORD

Cased _____ in., _____ ft.

Sand _____

Gas _____

Oil _____

Total Depth _____

PRODUCTION

1st 24 hrs. Nat. _____

1st 24 hrs. after shot _____

Gas _____ Cu. Ft.

Dry Hole _____

Abandoned _____

Date

APR 25 1928

S. J. LEWIS

Scout