


Map No. **KANSAS** Sec. **32** Twp. **13** R. **15w**Well No. **8-J. A. Mermis** Farm**Keigher** Company

NORTH

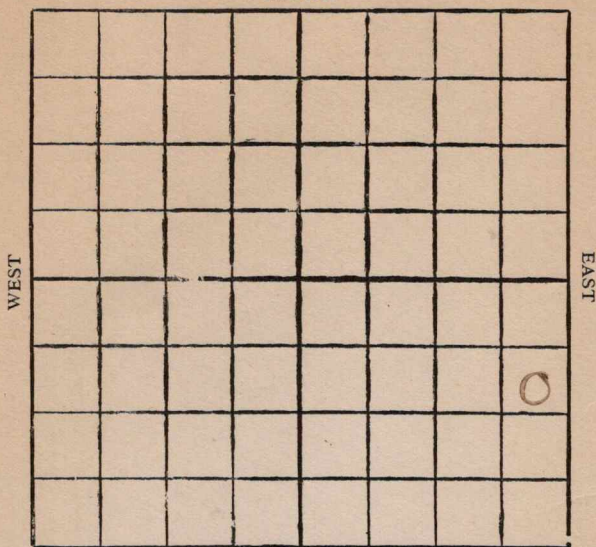

SOUTH

Location

Drilling Remarks

Rig Up.....

Drilling Remarks

RECORD

Cased.....in.ft.

Sand

Gas

Oil

Total Depth.....

PRODUCTION

1st 24 hrs. Nat.....

1st 24 hrs. after shot.....

Gas.....cu. ft.

Dry Hole.....

Abandoned.....

KANSAS

Map No. _____ Sec. 32 Twp. 13 R. 15WWell No. 8-J. A. Mermis FarmKeys Pet Company990 Ft. from N. Line

_____ Ft. from S. Line

330 Ft. from E. Line

_____ Ft. from W. Line

NORTH

WEST

EAST

SOUTH

1928

Date

REPORT

3/7	R. O. G.
3/14	<u>Rig</u>
3/21	<u>_____</u>
3/28	Rigged up S.D.
4/4	<u>Rig</u>
4/11	<u>_____</u>
4/18	Rigging up-
4/25	Drlg 498-
5/2	" 710
5/9	" 1557
5/16	" 1650
5/23	" 2500
5/31	" 2532
6/6	T.D. 2532 - S.D.
6/13	T.D. 3050 - U.R. 6"
6/20	Drlg 3055
6/27	Top Oswald sand 3059 - T.D. 3130 1200' oil in hole - rig burned
7/3	Rigging up-
7/11	T.D. 3130 Reblg Rig
7/18	T.D. 3130 - pulling big pipe -
7/25	Drlg 3220 -

8/1 - T.D. 3301 - run 5" - 738147

8/8 - Sand 3313½ - 3316½
Pumping 250 bbls

Map No. **KANSAS** Sec. 32 Twp. 13 R. 15W

Well No. S J A Morris

Kemp R.R. Company

Contractor

SECTION PLAT

990 Ft. from N. Line

_____ Ft. from S. Line

330 Ft. from E. Line

_____ Ft. from W. Line

			0

FIRST REPORTS

Location _____

Rig up _____

Drilling and Remarks:

ROG

RECORD

Cased _____ in., _____ ft.

Sand _____

Gas _____

Oil _____

Total Depth _____

PRODUCTION

1st 24 hrs. Nat. _____

1st 24 hrs. after shot _____

Gas _____ Cu. Ft.

Dry Hole _____

Abandoned _____

Date

MAR 7 1928

S. J. LEWIS

192

Scout

Map No. 70 Sec. 32 Twp. 13 R. 15WWell No. S. J. A. MermisReys P. & Company

Contractor

SECTION PLAT

990 Ft. from N. Line

Ft. from S. Line

330 Ft. from E. Line

Ft. from W. Line

			0

COMPLETED

Location

Rig up

Drilling and Remarks:

Sand 33 13 1/2to 33 16 1/2Pumping250 lbs 24 hrs

RECORD

Cased _____ in., _____ ft.

Sand _____

Gas _____

Oil _____

Total Depth _____

PRODUCTION

1st 24 hrs. Nat. _____

1st 24 hrs. after shot _____

Gas _____ Cu. Ft.

Dry Hole _____

Abandoned _____

Date

AUG 8 1928

192

S. J. LEWIS

Scout