
Form 51—5M—10-26—Mid-West

Greenwood

Map No. ..... Sec. 4 Twp. 27 R. 11

Well No. 1 — Ferguson Farm

Ward McGinnis Company

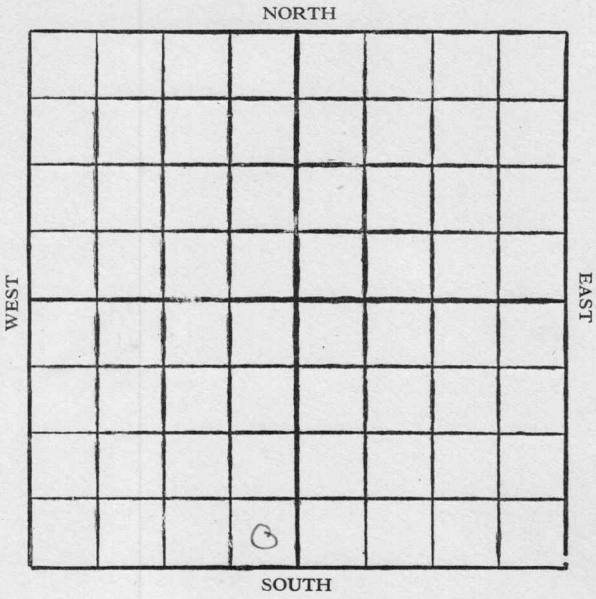


Location .....

Drilling Remarks

Rig Up .....

Drilling Remarks

RECORD

Cased ..... in. ..... ft.

Sand .....

Gas .....

Oil .....

Total Depth .....

PRODUCTION

1st 24 hrs. Nat. .....

1st 24 hrs. after shot .....

Gas ..... cu. ft.

Dry Hole .....


Abandoned .....

Form 252A—5M—4-27—27425

Map No. Kansas / Greenwood Sec. 4 Twp. 27 R 11

Well No. 1 Ferguson Farm

Ward-McGinnis Company

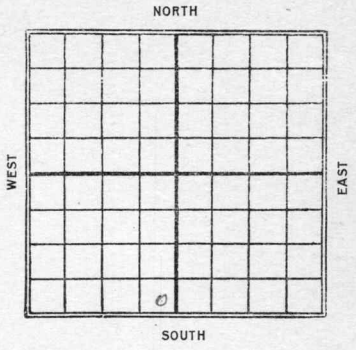


____ Ft. from N. Line

330 Ft. from S. Line

330 Ft. from E. Line

____ Ft. from W. Line

| Date 1927 | REPORT |
|---|---|
| 5/25 | Rigging up |
| 6/1 | Drlg 400 |
| 6/7 | " 850 |
| 6/15 | " 1000 |
| 6/22 | Sand 1788-1805 - hole full oil 32. gravity - |
| 6/29 | Sand 1788-1805 - T.D. 1805 oo bbls oil 28 gravity oil |

Form 26—1M Bks.—3-23—11959. Sherwood

9 KANSAS

Map No. _____ Sec. 4 Twp. 27 R. 11

Well No. 1 Ferguson

Ward Mc Sinnis Company

_____ Contractor

FIRST REPORTS


_____Ft. from N. Line

330 Ft. from S. Line

330 Ft. from E. Line

_____Ft. from W. Line

SECTION PLAT

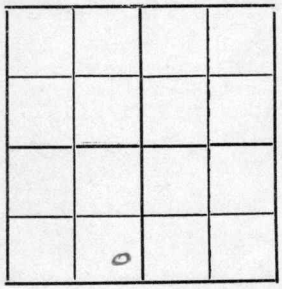

Location _____

Rig up _____

Drilling and Remarks:

Rigging up.

RECORD

Cased _____in., _____ ft.

Sand _____

Gas _____

Oil _____

Total Depth _____

PRODUCTION

1st 24 hrs. Nat. _____

1st 24 hrs. after shot _____

Gas _____Cu. Ft.

Dry Hole _____

Abandoned _____

Date

MAY 25 1927 CHAS. L. SHERWOOD

_____192____. _____Scout

Form 26—1M Bks.—3-23—11959. Sherwood

9 KANSAS

Map No. _____ Sec. 4 Twp. 27 R. 11


Well No. 1 Ferguson

Wary McGinnis _____ Company

_____ Contractor

COMPLETED

SECTION PLAT

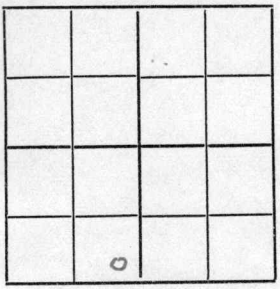

_____ Ft. from N. Line

330 Ft. from S. Line

330 Ft. from E. Line

_____ Ft. from W. Line

Location _____

Rig up _____

Drilling and Remarks:

50 Bbls.

28 Gravity Oil

RECORD

Cased _____ in., 8 ft.

Sand 1788-1805

Gas _____

Oil _____

Total Depth 1805

PRODUCTION

1st 24 hrs. Nat. _____

1st 24 hrs. after shot _____

Gas _____ Cu. Ft.

Dry Hole _____

Abandoned _____

Date

June 29 1927.

CHAS. L. SHERWOOD _____ Scout