



Map No. \_\_\_\_\_ Sec. 4 Twp. 27 R. 11


Well No. 2-Ferguson Farm  
Ward Mc Sinnie Company

\_\_\_\_\_ Ft. from N. Line

990 Ft. from S. Line

990 Ft. from E. Line

~~530~~ Ft. from W. Line

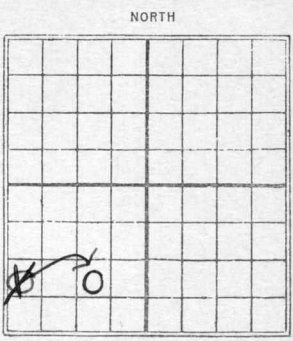

1927

Date

REPORT

Date	REPORT
<u>9/7</u>	<u>digging up</u>
<u>9/28</u>	<u>Drill 800'</u>
<u>10/6</u>	<u>" 1510</u>
<u>10/12</u>	<u>1820-1842 T.D. 1842</u>
	<u>Topline 1812</u>
	<u>100 bbls</u>

*Sherwood*

9 KANSAS  
Map No. \_\_\_\_\_ Sec. *4* Twp. *27* R. *11*

Well No. *2 Ferguson*

*Ward Mc Ginnis* Company

Contractor

FIRST REPORTS

SECTION PLAT

\_\_\_\_\_ Ft. from N. Line

*990* Ft. from S. Line

\_\_\_\_\_ Ft. from E. Line

*330* Ft. from W. Line

<i>0</i>			

Location \_\_\_\_\_

Rig up \_\_\_\_\_

Drilling and Remarks:

*Rigging up.*

RECORD

Cased \_\_\_\_\_ in., \_\_\_\_\_ ft.

Sand \_\_\_\_\_

Gas \_\_\_\_\_

Oil \_\_\_\_\_

Total Depth \_\_\_\_\_

PRODUCTION

1st 24 hrs. Nat. \_\_\_\_\_

1st 24 hrs. after shot \_\_\_\_\_

Gas \_\_\_\_\_ Cu. Ft.

Dry Hole \_\_\_\_\_

Abandoned \_\_\_\_\_

Date

SEP 7 - 1927

CHAS. L. SHERWOOD

192

Scout

*Sherwood*

9 KANSAS Map No. Sec. 4 Twp. 27 R. 11

Well No. *Ferguson*

*Ward Mc Sennis* Company

Contractor

CORRECTION

SECTION PLAT


----- Ft. from N. Line

*990* Ft. from S. Line

*990* Ft. from E. Line

----- Ft. from W. Line

Location -----

Rig up -----

Drilling and Remarks:

*800*

*Chg location*

RECORD

Cased ----- in., ----- ft.

Sand -----

Gas -----

Oil -----

Total Depth -----

PRODUCTION

1st 24 hrs. Nat. -----

1st 24 hrs. after shot -----

Gas ----- Cu. Ft.

Dry Hole -----

Abandoned -----

Date *SEP 28 1927*

CHAS. L. SHERWOOD

----- 192 ----- Scout

*Sherwood* ✓

9 KANSAS Sec. 4 Twp. 27 R. 11

Well No. *2 Ferguson*

*Ward Mc Bunnis* Company

Contractor

COMPLETED

SECTION PLAT

	0		

----- Ft. from N. Line

*990* Ft. from S. Line

*990* Ft. from E. Line

----- Ft. from W. Line

Location -----

Rig up -----

Drilling and Remarks:

*Top line 1810*

*100 Bl.*

RECORD

Cased *18* in., ----- ft.

Sand *1820-1842*

Gas -----

Oil -----

Total Depth *1842*

PRODUCTION

1st 24 hrs. Nat. -----

1st 24 hrs. after shot -----

Gas ----- Cu. Ft.

Dry Hole -----

Abandoned -----

Date

OCT 12 1927

CHAS. L. SHERWOOD

192

Scout