


Section 4 Township 27 Range 11E

Well No. #3 Ferguson

Company Sam Springer

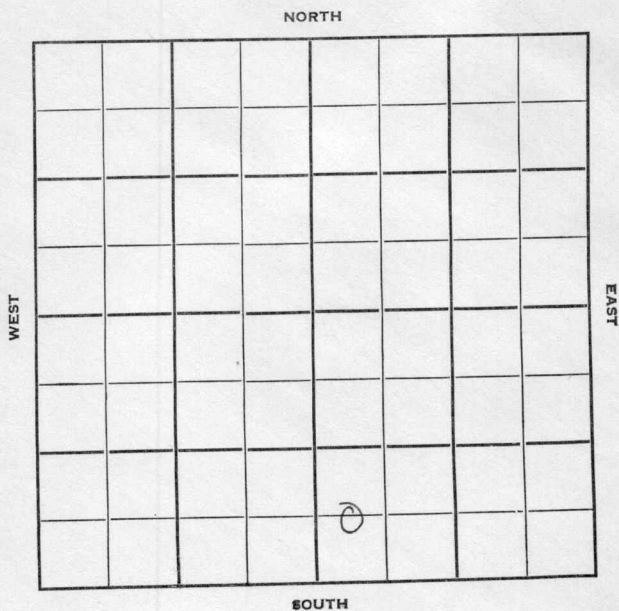

Greenwood

KANSAS
11E

Sec. 4 Twp. 27 R. 11E

Well No. #3 Ferguson Farm

Sam Springer Company

Contractor

Miscellaneous


 Ft. from N. Line

660' Ft. from S. Line

 Ft. from E. Line

330' Ft. from W. Line

C W L SW SE

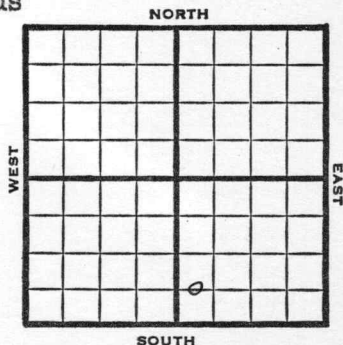

1950

REPORT

6/14

Location

8/2

12" @ 40

10" @ 665

Miss 1791

6" @ 1791

TD 1800

500 a P/all wtr

D&A

ABANDONED

Kansas

Map No. _____ Sec. 4 Twp. 27 R. 11EWell No. 3 FergusonSam Springer Company

Contractor

C W L SW SE

SECTION PLAT

_____ Ft. from N. Line

660 Ft. from S. Line

_____ Ft. from E. Line

330 Ft. from W. Line

Greenwood County

Location X

Rig up _____

Drilling and Remarks:

RECORD

Cased _____ in., _____ ft.

Sand _____

Gas _____

Oil _____

Total Depth _____

PRODUCTION

1st 24 hrs. Nat. _____

1st 24 hrs. after shot _____

Gas _____ Cu. Ft.

Dry Hole _____

Abandoned _____

Date

JUN 14 1950 19J. E. TYRA Scout

County Greenwood State Kansas
 Sec. 4 (Blk.) 27 (Sur.) 11E Map No.
 Operator Sam Springer
 Well No. 3 Farm Ferguson
 Elev. Location C W L SW SE



660 Ft. From S Line SE
330 Ft. From W Line Quarter
 1st. Report
 Completion AUG 2 1950
 Remarks
 Spudding Date

Drlg. Data

12" @ 40 10" @ 665 Miss. 1791

6" @ 1791 TD 1800 500 A P/ all water

D & A

J. E. TYRA