


Ma Pherson

Form 51-5M-11-31-Palace

Map No. **KANSAS** Sec. 20 Twp. 19 R. 1W

Well No. 5 Coons Farm
Darby Pet. Company

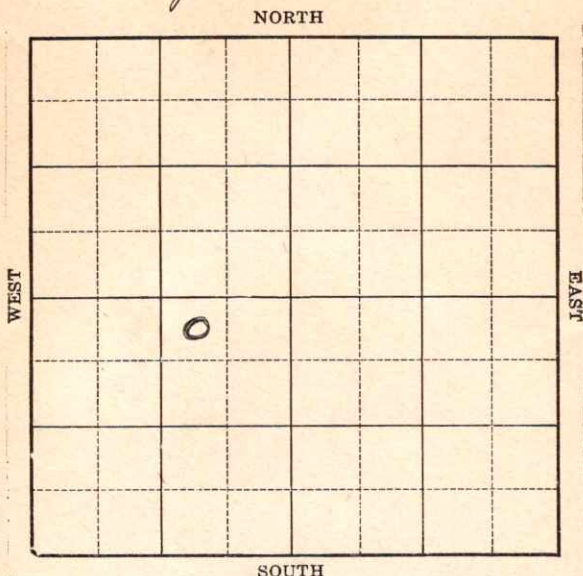

Location

Drilling Remarks

Rig Up

Drilling Remarks

RECORD

Cased in. ft.

Sand

Gas

Oil

Total Depth

PRODUCTION

1st 24 hrs. Nat.

1st 24 hrs. after shot

Gas cu. ft.

Dry Hole

Abandoned

McPherson


Map No. **KANSAS** Sec. 20 Twp. 19 R. 1W
 Well No. 5 Coone Farm
Darby Pet. Company

330 Ft. from N. Line

..... Ft. from S. Line

990 Ft. from E. Line

..... Ft. from W. Line

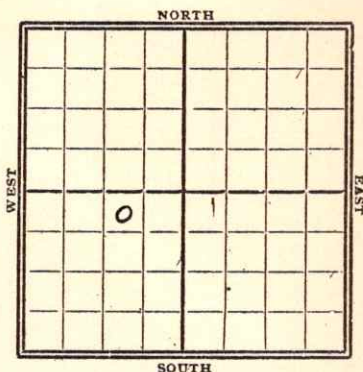

Date

REPORT

7/9/34
 4/11 Location
 4/19 15" 132 H.O.C.
 4/26 Bldg 1800
 5/3 " 2775 K.C.L. 2350
 5/10 " 3400 Top Chat 2937
 B. Line 3176
 5/18 Run 8" 3400
 5/25 TV 3414 6" liner 3414
 let oil 3419 TD 3426
 1000 acid
 5/30 Top Viola 3414 TD 3426
 1000 Gal acid Est 200 Bbls.

COMPLETED

Map No. 43 Sec. 20 Twp. 19 R. 1WWell No. 5 - CoonoDarby pit.

Company

Contractor

FIRST REPORT

SECTION PLAT

330 Ft. from N. Line

Ft. from S. Line

990 Ft. from E. Line

Ft. from W. Line

	0		

Location ✓

Rig up

Drilling and Remarks:

RECORD

Cased in., ft.Sand Gas Oil Total Depth

PRODUCTION

1st 24 hrs. Nat. 1st 24 hrs. after shot Gas Cu. Ft.Dry Hole Abandoned

Date

4-11-34 192 O. Mannschreck Scout

Map No. 43 Sec. 20 Twp. 19 R. 1WWell No. 5 CoonsHarty Pet. Company

Contractor

SECTION PLAT

	COMPLETE		
	0		

330 Ft. from N. Line

_____ Ft. from S. Line

990 Ft. from E. Line

_____ Ft. from W. Line

Location _____

Rig up _____

Drilling and Remarks:

Top Viola 3414TID 34261000 gal acidEst. 200 x 4.

RECORD

Cased _____ in., _____ ft.

Sand _____

Gas _____

Oil _____

Total Depth _____

PRODUCTION

1st 24 hrs. Nat. _____

1st 24 hrs. after shot _____

Gas _____ Cu. Ft.

Dry Hole _____

Abandoned _____

Date

5/3019 34

ORVAL MANNSCHECK Scout