

NORTH

WEST

EAST

SOUTH

Location

Drilling Remarks

Rig Up

Drilling Remarks

RECORD

Cased_____in. _____ft.

Sand.....

Gas

Oil

Total Depth.....

PRODUCTION

1st 24 hrs. Nat. _____

1st 24 hrs. after shot-----

Gas _____ cu. ft. _____

Dry Hole.....

Abandoned_____


Greenwood

Map No. Sec. 4 Twp. 27 R. 11E

Well No. 1- Rush Farm

Everly & Pendergrass Company

NORTH

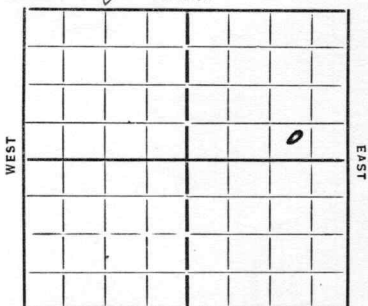

Ft. from N. Line

330

Ft. from S. Line

990

Ft. from E. Line

Ft. from W. Line

SOUTH

Date *7/25*

REPORT

3/27 Mch.
4/4 dly 400
4/11 s 400
4/18 — 4/26 —
5/2 dly 410
5/9 s 410
5/16 — 5/23 —
5/29 s 500
6/4 —
6/13 dly 1000
6/20 —
6/28 dly 1200
7/3 " 1550
7/14 " 1700
7/17 T 1838

J. F. A.

ABANDONED

Map No. 9 Sec. 4 Twp. 27 R. 11EWell No. 1- RushEverly + Bendergrass Company

Contractor

FIRST REPORT

SECTION PLAT

			0

Ft. from N. Line

330 Ft. from S. Line990 Ft. from E. Line

Ft. from W. Line

RECORD

Location

Cased in, ft.

Rig up

Sand

Drilling and Remarks:

Gas

Oil

Total Depth

PRODUCTION

1st 24 hrs. Nat.

1st 24 hrs. after shot

Gas Cu. Ft.

Dry Hole

Abandoned

Date

ORVAL MANNSCHRECK

3-27-35 192

Scout

Map No. 9 Sec. 4 Twp. 27 R. 11EWell No. 1-RushEverly + Pendergrass Company

Contractor

ABANDONED

SECTION PLAT

			0

Ft. from N. Line

330 Ft. from S. Line990 Ft. from E. Line

Ft. from W. Line

Location

Rig up

Drilling and Remarks:

10 + 7

RECORD

Cased _____ in., _____ ft.

Sand _____

Gas _____

Oil _____

Total Depth 1838

PRODUCTION

1st 24 hrs. Nat. _____

1st 24 hrs. after shot _____

Gas _____ Cu. Ft.

Dry Hole _____

Abandoned _____

Date

7-17-35 192

ORVAL MANNSCHRECK

Scout