


Russell

Form 51-5M-5-34-Palace

Map No. KANSAS Sec. 32 Twp. 13 R. 15^w

Well No. 31 J. E. Baxter Farm
Stanolind Oil Co. Company

NORTH

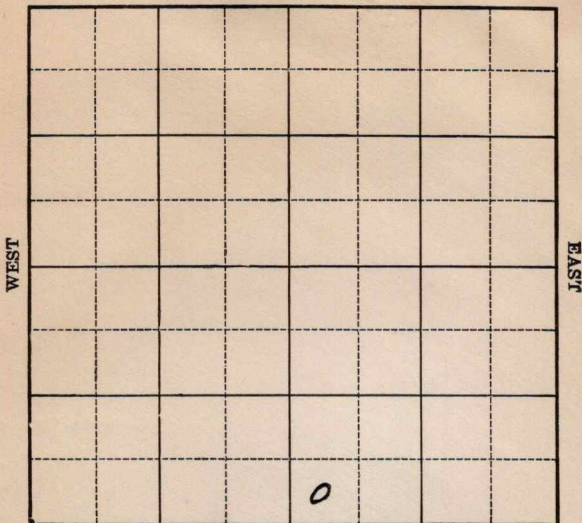

SOUTH

Location _____
Drilling Remarks _____

Rig Up _____
Drilling Remarks _____

RECORD

Cased _____ in. _____ ft.
Sand _____
Gas _____
Oil _____
Total Depth _____

PRODUCTION

1st 24 hrs. Nat. _____
1st 24 hrs. after shot _____
Gas _____ cu. ft. _____
Dry Hole _____
Abandoned _____

Russell

Map No. KANSAS Sec. 32 Twp. 13 R. 15W


Well No. 31 J. E. Baxter Farm
Stensliek O & H Company

 Ft. from N. Line

330 Ft. from S. Line

 Ft. from E. Line

330 Ft. from W. Line

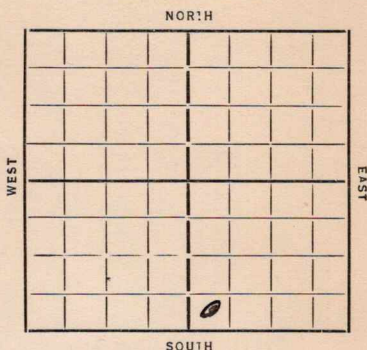

Date 1955

REPORT

1/9	Location
1/14	Cellar
1/24	Rgn Rot.
1/31	Alg 400
2/7	" 1509
2/14	" 2000
2/21	" 2800
2/28	— 3/7 —
3/14	Alg 2800
3/21	—
3/28	Alg 2878
4/4	Oswald 3055 Pay 3078-81
	5" cem 3060 WOC
4/11	Alg cement
4/18	S.O. & W. 3083 T7 3101 Acidizing
4/26	Seal 60 oil 48 water
5/2	—
5/8	Oswald 3055 T7 3101
	1000 acid 46 oil 70 Water

COMPLETED

Map No. 77 Sec. 32 Twp. 13 R. 15WWell No. 31- G. E. BaxterStanoline oil Company

Contractor

COMPLETED

SECTION PLAT

		0	

Ft. from N. Line

330 Ft. from S. Line

Ft. from E. Line

330 Ft. from W. Line

Location

Rig up

Drilling and Remarks:

1000 and46 oil
70 water

RECORD

Cased in., ft.Sand Orval 3055

Gas

Oil

Total Depth 3101

PRODUCTION

1st 24 hrs. Nat.

1st 24 hrs. after shot

Gas Cu. Ft.

Dry Hole

Abandoned

Date

5-8-35 192

ORVAL MANNSCHRECK

Scout

738223

I show Completed Out Will no number
 here operated by Mid-West.
 Is this a turn?

J.W. Smith

11/17/35

no trace

Returned

Cards

Tracing

France Map

Searborough Map

Moody Map

Searborough Plat Book

Moody Plat Book

KANSAS

Map No. 72 Sec. 32 Twp. 13 R. 15WWell No. 31- J. E. BaxterStandline Oil Co. Company

Contractor

SECTION PLAT

FIRST REPORTS

Ft. from N. Line

330 Ft. from S. Line

Ft. from E. Line

330 Ft. from W. Line

		0	

Location ✓

Rig up

Drilling and Remarks:

RECORD

Cased in., ft.Sand Gas Oil Total Depth

PRODUCTION

1st 24 hrs. Nat. 1st 24 hrs. after shot Gas Cu. Ft.Dry Hole Abandoned

Date

ORVAL MANNSCHRECK

1-9-35 192 Scout