


Section 32 Township 13 Range 15W

Well No. #1 Mermis

Company Anderson-Prichard

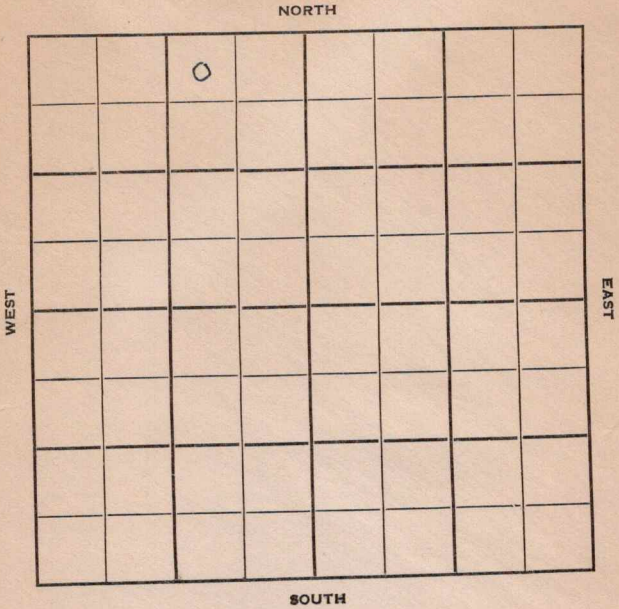

Russell

KANSAS ✓

Sec. 32 Twp. 13 R. 15W

Well No. #1 Mermis Farm

Anderson-Prichard

Gorham Pool (Lindas Drlg., Contr.) Company

NORTH


330' Ft. from N. Line

Ft. from S. Line

990' Ft. from E. Line

Ft. from W. Line

NW NE NW

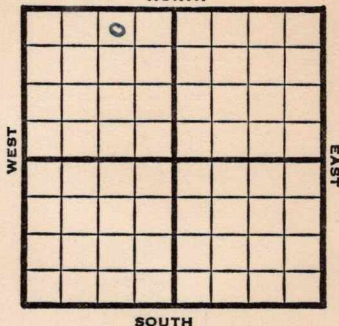

1950

Elev 1910'

REPORT

1/4 8-5/8" @ 349'

3/15 TD 3348'
8 5/8" @ 349'
5" @ 3333'
Plug back to 3245'
79 BOPD
Anhy 957'
Topeka 2801'
Lans 3070'
Comp

COMPLETED

Kansas

Map No. _____ Sec. 32 Twp. 13 R. 15WWell No. 1 Mermis

_____ Anderson-Prichard _____ Company

_____ Lindas Drlg. _____ Contractor

NW NE NW

SECTION PLAT

	○		

330 Ft. from N. Line

_____ Ft. from S. Line

990 Ft. from E. Line

_____ Ft. from W. Line

Russell County

Location _____

Rig up _____

Drilling and Remarks:

8 5/8" @ 349

RECORD

Cased _____ in., _____ ft.

Sand _____

Gas _____

Oil _____

Total Depth _____

PRODUCTION

1st 24 hrs. Nat. _____

1st 24 hrs. after shot _____

Gas _____ Cu. Ft.

Dry Hole _____

Abandoned _____

Date

JAN 4 195019W E. TYRA Scout

Kansas

Gorham Pool

Map No. _____ Sec. 32 Twp. 13 R. 15WWell No. 1 MermisAnderson-Prichard Company

Contractor


NW NE NW

FIRST REPORT
SECTION PLAT330 Ft. from N. Line

_____ Ft. from S. Line

990 Ft. from E. Line

_____ Ft. from W. Line

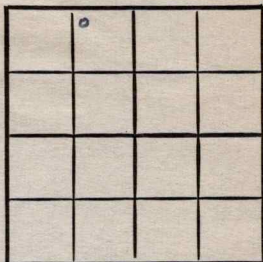

Russell County

Location X

Rig up _____

Drilling and Remarks:

RECORD

Cased _____ in., _____ ft.

Sand _____

Gas _____

Oil _____

Total Depth _____

PRODUCTION

1st 24 hrs. Nat. _____

1st 24 hrs. after shot _____

Gas _____ Cu. Ft.

Dry Hole _____

Abandoned _____

Date

DEC 28 1949 19S. J. LEWIS

Scout

Kansas

Map No. _____ Sec. 32 Twp. 13 R. 15WWell No. 1 MermisAnderson-Prichard

Company

Contractor

NW NE NW

E1. 1910

SECTION PLAT

330

Ft. from N. Line

Ft. from S. Line

990

Ft. from E. Line

Ft. from W. Line

Russell County

	0		
COMPLETE			

Location _____

Rig up _____

Drilling and Remarks:

8 5/8" @ 3495" @ 3333Plug back to 324579 BOPD

RECORD

Cased _____ in., _____ ft.

Sand _____

Gas _____

Oil _____

Total Depth 3348

PRODUCTION

1st 24 hrs. Nat. _____

1st 24 hrs. after shot _____

Gas _____ Cu. Ft.

Dry Hole _____

Abandoned _____

Date

Tops over

MAR 15 1950

19

J. E. TYRA

Scout

anby 957
Jopka 2801
Lansing 3070

SECTION PLAT



_____ Ft. from N. Line
_____ Ft. from S. Line
_____ Ft. from E. Line
_____ Ft. from W. Line

RECORD

Cased _____ in _____ ft.
Sand _____
Gas _____
Oil _____
Total Depth _____

Location _____
Rig up _____
Drilling and Remarks _____

MAR 22 1950

Edith

Scout Cards	_____
Land Small Map	_____
Land Wall Map	_____
Tracings	_____
France Map	_____
Pierce Map	_____
Misc.	_____

Date