


Section 7 Township 27 Range 11 E

Well No. # 1 Grundy

Company Carlisle & McCoy

NORTH

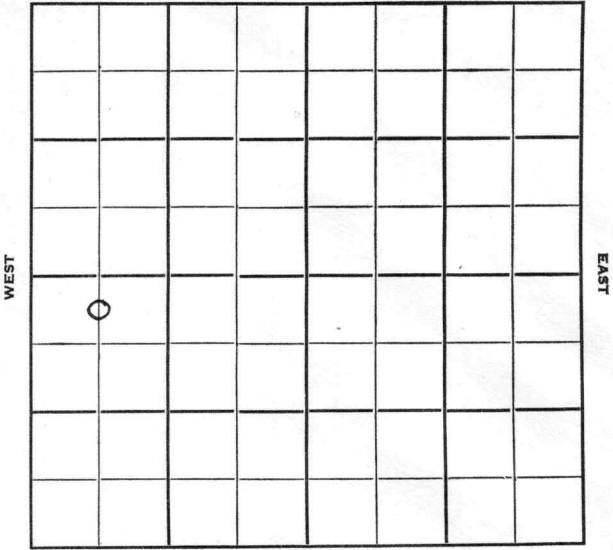

SOUTH

Greenwood

KANSAS

Sec. 7 Twp. 27 R. 11E ✓

Well No. #1 Grundy Farm

Carlisle & McCoy Company

Contractor


330' Ft. from N. Line

_____ Ft. from S. Line

_____ Ft. from E. Line

660' Ft. from W. Line

C N L NW SW

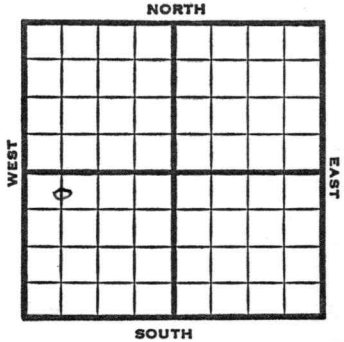

1951

Elev. ?

REPORT

5/9

Miss 1898-
TD 1916
D&A

**FIRST REPORT
&
ABANDONED**

County **Greenwood** State **Kansas**

Sec. **7** (Blk. **27**) (Sur. **11E**) Map No.

Operator **Carlisle & McCoy**

Well No. **1** Farm **Grundy**

Elev. Location **C N L NW SW**



330 Ft. From **N** Line **SW**

660 Ft. From **W** Line Quarter

Ist. Report **MAY 9 1951**

Completion **MAY 9 1951**

Remarks

Spudding Date

Drlg. Data

Miss 1898-1916 TD D & A