


Section 21 Township 19S Range 1W

Well No. #1 Lively

Company Cal Jones

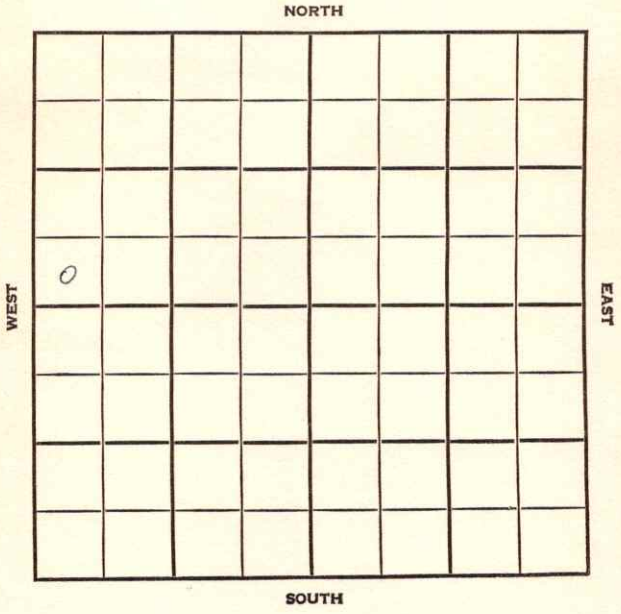

SEC. 21	TWP. 19	R. 1W
------------	------------	----------

WELL NO. #1 Lively FARM

COMPANY Cal Jones

CONTRACTOR Melland


Ritz-Canton

\_\_\_\_\_ FT. FROM N. LINE

\_\_\_\_\_ FT. FROM S. LINE

\_\_\_\_\_ FT. FROM E. LINE

\_\_\_\_\_ FT. FROM W. LINE

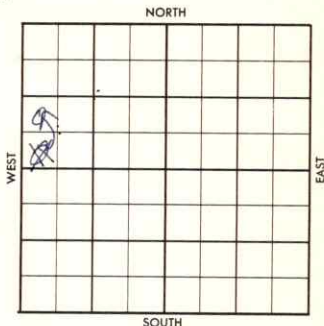

<sup>NW</sup>  
SW SW NW  
(Twin to DH)

1956	ELEVATION	REPORT
------	-----------	--------

8-29 Location

~~CORRECTION~~

FORM 513 SUNRAY

County McPherson Elev. 1587  
 Sec. 21 Twp. 19S Rge. 1W  
 Company Gal Jones  
 Farm Name Lively No. 1

TOPS	DEPTH	LOG	DATUM	Loc. in Sec.
Anh.				<u>SW SW NW</u>
TP				<u>NW</u>
H.				<u>DS -SW NW</u>
Tr.				
Dg.				
Bl.				
L.	<u>2324</u>			Geol.
K.C.				Contr.
B.K.C.				<u>Melland</u>
Ce.				
C.	<u>2900</u>			Pool <u>Ritz</u>
M.				<u>Canton</u>
M.	<u>3103</u>			
K.				
Mz.				
Me.				
V.	<u>3356</u>			
S. <u>sd</u>	<u>3398</u>			
S.				
A.				
R.				
Pe.				<b>COMPLETE</b>
G.				SEP 26 '56
T.D.	<u>3404</u>			

Date Comm. SEP 5 '56  
 Loc. (twin to DH) 8-31-56  
8 5/8 154/90 @ 2530 SEP 12 '56  
5 1/2 3399. SEP 19 '56 Co DD 3410  
P. 25 Bopd + 45 % wt.  
complete

County McPherson Elev. \_\_\_\_\_  
 Sec. 21 Twp. 19S Rge. 1W  
 Company Cal Jones  
 Farm Name Lively No. 1

TOPS	DEPTH	LOG	DATUM	Loc. in Sec.
Anh.				SW SW NW
Tp.				DS -SW NW
H.				
Tr.				
Dg.				
Bl.				
L.				Geol. _____
K.C.				Contr. _____
B.K.C.				
Ce.				<u>Melland</u>
C.				
M.				Pool <u>Ritz</u>
M.				<u>Canton</u>
K.				
Mz.				
Me.				
V.				
S.				
S.				
A.				
R.				
PE.				
G.				
T.D.				

FIRST REPORT  
 0  
 AUG 29 '56

Date Comm.

Loc. (twin to DH)

284 2 1928

R.G.R.