

Greenwood


KANSAS ✓

Form 51-5M-7-39-Palace

Section 7 Township 27 Range 11-E

Well No. #1 Grundy

Company R. F. Youker

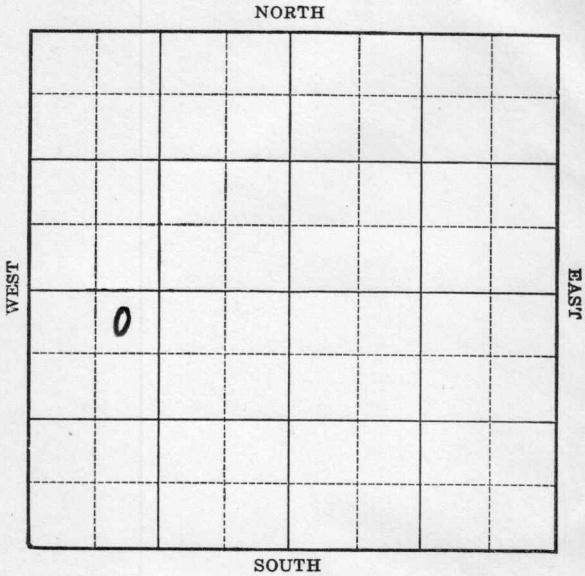

Map No. 9 Sec. 7 Twp. 27 R. 11E

Well No. 1 Grundy

R. F. Youker

Company _____

Contractor _____

FIRST REPORT

SECTION PLAT

NE NW SW

330 Ft. from N. Line

_____ Ft. from S. Line

_____ Ft. from E. Line

990 Ft. from W. Line

o			

MISCELLANEOUS

RECORD

Location _____

Cased _____ in., _____ ft.

Rig up _____

Sand _____

Drilling and Remarks:

Gas _____

Machine

Oil _____

Spud 105

Total Depth _____

PRODUCTION

1st 24 hrs. Nat. _____

1st 24 hrs. after shot _____

Gas _____ Cu. Ft.

Dry Hole _____

Abandoned _____

Date _____

APR 3 1940

S. J. LEWIS Scout

Map No. 9 Sec. 7 Twp. 27 R. 11E

Well No. 1 Grundy

R. F. Youker Company

Contractor

ABANDONED

SECTION PLAT

330 NE NW SW
Ft. from N. Line

_____ Ft. from S. Line

_____ Ft. from E. Line

990 Ft. from W. Line

o			

MISCELLANEOUS

Location _____

Rig up _____

Drilling and Remarks:

Nov 1909
Water.

RECORD

Cased _____ in., _____ ft.

Sand _____

Gas _____

Oil _____

Total Depth 1916

PRODUCTION

1st 24 hrs. Nat. _____

1st 24 hrs. after shot _____

Gas _____ Cu. Ft.

Dry Hole _____

Abandoned _____

Date

MAY 8 1940 19

S. J. LEWIS Scout