


Greenwood

KANSAS

Section 7 Township 27 Range 11E

Well No. #4 Holms

Company Central Oil

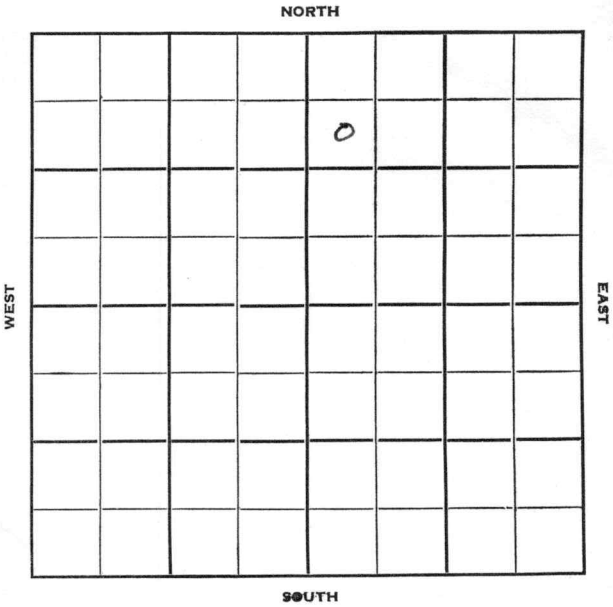


Sec. 7 Twp. 27 R. 11E

Well No. #4 Holms Farm

Central Oil Company

Uhl - Contr. Contractor

990' Ft. from N. Line  
 \_\_\_\_\_ Ft. from S. Line  
 \_\_\_\_\_ Ft. from E. Line  
330' Ft. from W. Line

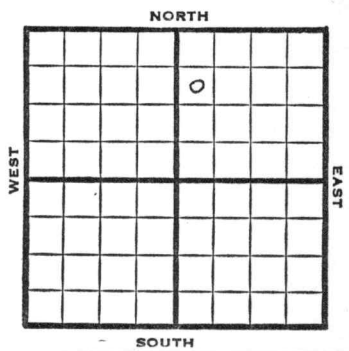

SW NW NE

1950	Elev ? REPORT
12/6	10" @ 37' Drlg. 1532'
1951 1/10	10" @ 37 Miss 1894 TD 1906 7" @ 1901 Comp 15 bopd Completed <b>COMPLETED</b>



