

Map No. KANSAS Sec. 7 Twp. 27 R. 11

Well No. 2 - Cross Brandy
Mohawk O. & G. Company

Ft. from N. Line

990

Ft. from S. Line

~~1120~~


Ft. from E. Line

990

Ft. from W. Line

~~1120~~

NORTH

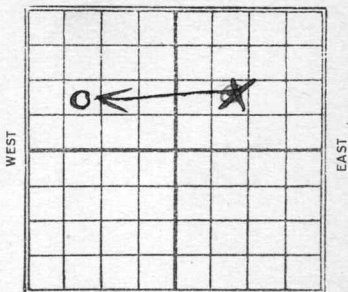

SOUTH

1928

Date

REPORT

Date	REPORT
<u>2/9</u>	<u>Location</u>
<u>2/16</u>	<u>—————</u>
<u>2/23</u>	<u>—————</u>
<u>2/28</u>	<u>Rigging up-</u>
<u>3/8</u>	<u>Rigged up + J.D.</u>
<u>3/16</u>	<u>Dry 1100-</u>
<u>3/22</u>	<u>Setting 8" - 1600</u>
<u>3/28</u>	<u>Burgess 1875-1884</u>
	<u>T.D. 1884</u>
	<u>dry B.V. sd. 1707-45'</u>
	<u>100 bbls 30 gravity</u>

Gymwood

9 KANSAS
Map No. _____ Sec. 7 Twp. 27 R. 11

Well No. 2 Cross
Mohawg Oil Co Company

Contractor

FIRST REPORTS

SECTION PLAT

Ft. from N. Line

1120
Ft. from S. Line

Ft. from E. Line

1120
Ft. from W. Line

		o	

Location

Rig up _____

Drilling and Remarks:

RECORD

Cased _____ in., _____ ft.

Sand _____

Gas _____

Oil _____

Total Depth _____

PRODUCTION

1st 24 hrs. Nat. _____

1st 24 hrs. after shot _____

Gas _____ Cu. Ft.

Dry Hole _____

Abandoned _____

Date

FEB 9 1928

CHAS. L. SHERWOOD

192

Scout

Sherwood

KANSAS

Map No. ----- Sec. 7 Twp. 27 R. 11

Well No. 2 *Sherwood*

Mohawk Oil Co ----- Company

----- Contractor

CORRECTION

~~COMPLETED~~

SECTION PLAT

o	←	o	

----- Ft. from N. Line

990 ----- Ft. from S. Line

----- Ft. from E. Line

990 ----- Ft. from W. Line

Location -----

Rig up -----

Drilling and Remarks:

*Chg Farm Name
and location*

RECORD

Cased ----- in., ----- ft.

Sand -----

Gas -----

Oil -----

Total Depth -----

PRODUCTION

1st 24 hrs. Nat. -----

1st 24 hrs. after shot -----

Gas ----- Cu. Ft.

Dry Hole -----

Abandoned -----

Date

MAR 28 1928

CHAS. L. SHERWOOD

Sherwood

9 KANSAS Map No. Sec. 7 Twp. 27 R. 11

Well No. *2* *Shurley*
Nohawk Oil Co Company

Contractor

COMPLETED

SECTION PLAT

----- Ft. from N. Line

990 Ft. from S. Line

----- Ft. from E. Line

990 Ft. from W. Line

<i>o</i>			

Location ----- *Burgess*

Rig up -----

Drilling and Remarks:

Dry bo to 1707-45'

100 lbs

30 gravity

RECORD

Cased ----- in., ----- ft.

Sand *1875-1884*

Gas -----

Oil -----

Total Depth *1884*

PRODUCTION

1st 24 hrs. Nat. -----

1st 24 hrs. after shot -----

Gas ----- Cu. Ft.

Dry Hole -----

Abandoned -----

Date

MAR 23 1928

CHAS. L. SHERWOOD

192-----

Scout