

McPherson

KANSAS

21

19


1W

SECTION _____ TOWNSHIP _____ RANGE _____

WELL NO. #2 Lively

COMPANY Cal Jones

NORTH

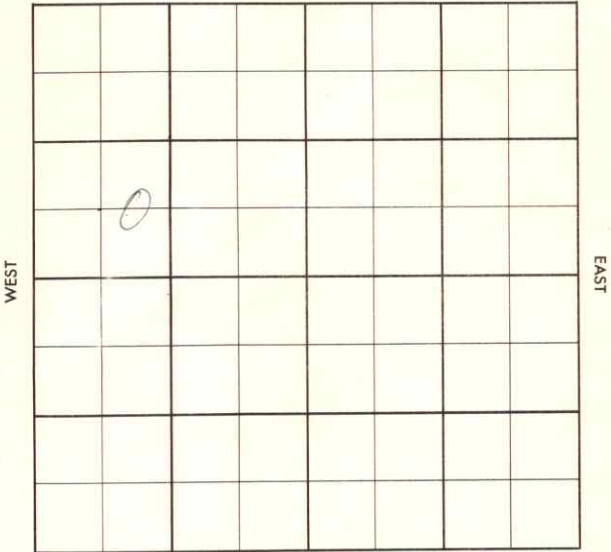

SOUTH

County McPherson Elev. 1587 DF
 Sec. 21 Twp. 19 Rge. 1W
 Company Cal Jones
 Farm Name Lively No. 2

TOPS	DEPTH	LOG	DATUM	Loc. in Sec.
Anh.				C E/2 SW NW
TP.				
H.				
Tr.				
Dg.				
Bl.				
L.	2328			Geol.
K.C.				Cantr.
B.K.C.				Melland Tools
Ce.				Pool
C.	2901			Ritz-Canton
M.				
M.				
K.				
Mz.				
Mo.				
V.				
S.				
A.				
R.				
PE.				
G.				
TD.	2987			

COMPLETE
 o
 DEC 13 '56

Date Comm.

Location 24⁵⁶ 10-18-568⁵/8 150/100 11 2355 OCT 31 '565¹/2 2984 NOV 7 '56 100 CT. NOV 13 '56 ✓NOV 21 '56 NOV 28 '56 11 10 DEC 5 '56 DEC 12 '56CO 2987 TD 550 24/2978-82est P. 25 Bopd + Lots wto.

